

Washington
F 1001

MISSISSIPPI
BOARD OF WATER COMMISSIONERS
416 North State Street
Jackson, Mississippi 39201

WATER WELL DRILLERS LOG

8-5 1983 Schultz Drilling Washington
date well completed firm name county well located

LANDOWNER:
Gus PIERALISI
Leland MS
(mailing address)

description of formations encountered	from	to
Clay	0	20
COARSE SAND	20	60
COARSE SAND + PIEA GRAVEL	60	95

WELL LOCATION:
sec. 4 T. 18 N. R. 6 E
4 miles NE of Leland
(distance) (direction) (nearest town)

WELL PURPOSE: IRRIGATION
(home, irrigation, municipal, industrial)

- WELL COMPLETION DATA:
- (1) diameter (inches) 10"
 - (2) total depth (feet) 95'
 - (3) static water level (feet) 22' below top of ground.
 - (4) casing PVC, 55' (material) (depth)
10" (size) If telescope see back.
 - (5) screen 40', 55' (length) (depth to top)
10" PVC (size) (material)
 - (6) pump 2 (HP) 2 (yield gpm)
2 (type power)
 - (7) electric log NO (yes or no)
(organization running log)
 - (8) how well bottom plugged per cap

DEPT. OF NATURAL RESOURCES
BUREAU OF LAND & WATER RESOURCES


AUG 11 1983

RECEIVED

DRILLERS REMARKS:

If well telescopes please sketch and show depths.

GROUND LEVEL

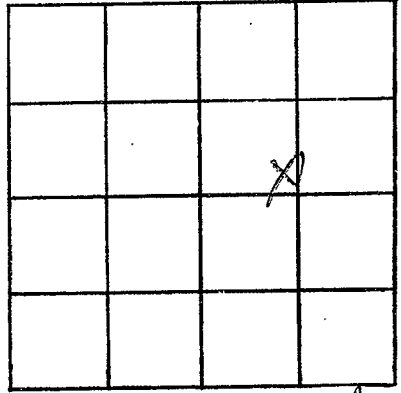

SECTION

4

Please indicate well location X.

ADDITIONAL INFORMATION

If more than one screen, show locations of each on sketch.