

WASHINGTON
 F 2000
 7/9/76

MISSISSIPPI
 BOARD OF WATER COMMISSIONERS
 416 North State Street
 Jackson, Mississippi 39201
 WATER WELL DRILLERS LOG

July 9 1976 Bruce Berryman - Greenwood WASHINGTON
 date well completed firm name county well located

LANDOWNER: George Rice
 Indianola, Miss.

description of formations encountered	from	to
Clay	0	50
Sand	50	107

(mailing address)

WELL LOCATION:

sec. 13 T 18 N R 6 E
 7 miles SW of Indianola
 (distance) (direction) (nearest town)

WELL PURPOSE: Farm
 (home, irrigation, municipal, industrial)

WELL COMPLETION DATA:

- (1) diameter (inches) 4"
- (2) total depth (feet) 106 ft.
- (3) static water level (feet) 21 below top of ground.
- (4) casing P.V.C. 106 ft.
 (material) (depth)
- (size) if telescope see back.
- (5) screen 10 ft. 96 ft.
 (length) (depth to top)
- .010 P.V.C.
 (size) (material)
- (6) pump 3 50
 (HP) (yield gpm)
- Electric
 (type power)
- (7) electric log No
 (yes or no)

(organization running log)
 B.P.V.


DRILLERS REMARKS:

RECEIVED
 OCT 5 1976

MISS. BD. OF WATER COMMISSIONERS

If well telescopes please sketch and show depths.

GROUND LEVEL

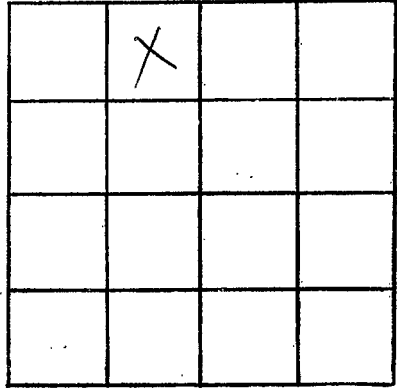

SECTION 13

Please indicate well location X.

ADDITIONAL INFORMATION

If more than one screen,
show locations of each on sketch.