

Washington  
 F 2003  
 11/9/77

MISSISSIPPI  
 BOARD OF WATER COMMISSIONERS  
 416 North State Street  
 Jackson, Mississippi 39201

WATER WELL DRILLERS LOG

Nov. 9 1977 Schultz Drilling Co. Washington  
 date well completed firm name county well located

LANDOWNER: Robert Swanwick

description of formations encountered	from	to
Clay	0	20
Sand	20	80
Clay	80	180
Sandy Shale	180	240
Sandy Shale	240	380
Sand fine SAND	380	415
	415	460

Greenville  
 (mailing address)

WELL LOCATION:  
 sec. 20 T. 18 S. R. 1 E. 1  
 4 miles east of Lebanon  
 (distance) (direction) (nearest town)

WELL PURPOSE: home  
 (home, irrigation, municipal, industrial)

WELL COMPLETION DATA:

- (1) diameter (inches) 4x2
- (2) total depth (feet) 460
- (3) static water level (feet) 24 below top of ground.
- (4) casing PVC 450 (material) (depth)
- (size) if telescope see back.
- (5) screen 30 430 (length) (depth to top)
- 2in PVC (size) (material)
- (6) pump 1 (HP) (yield gpm)
- (type power)
- (7) electric log NO (yes or no)
- (organization running log)
- (8) how well bottom plugged B/w


RECEIVED

NOV 30 1977

DRILLERS REMARKS:

If well telescopes please sketch and show depths.

GROUND LEVEL

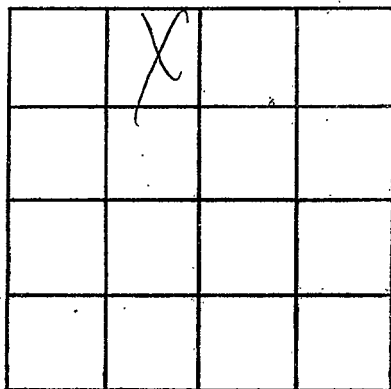

SECTION \_\_\_\_\_

Please indicate well location X.

ADDITIONAL INFORMATION

If more than one screen,  
show locations of each on sketch.