

Washington
 F 2004
 8/5/77

MISSISSIPPI
 BOARD OF WATER COMMISSIONERS
 416 North State Street
 Jackson, Mississippi 39201

WATER WELL DRILLERS LOG

August 5 1977 Schultz Drilling Co. Washington
 date well completed firm name county well located

LANDOWNER: Tony Zepponi
 Rt. 2, Box L 15
 Leland, MS
 (mailing address)

WELL LOCATION:
 sec. 20 T. 18 N R. 6 E
 S W
 4 miles east of Leland
 (distance) (direction) (nearest town)

WELL PURPOSE: home
 (home, irrigation, municipal, industrial)

WELL COMPLETION DATA:

(1) diameter (inches) 4 in X 2 in

(2) total depth (feet) 470 ft.

(3) static water level (feet) 28 ft. below top of ground.

(4) casing Steel 450 (material) (depth)
 (size) if telescope see back.

(5) screen 20 450 (length) (depth to top)
 2 stainless (size) (material)

(6) pump 3 50 (HP) (yield gpm)
 (type power)

(7) electric log NO (yes or no)
 (organization running log)

(8) how well bottom plugged b/w

description of formations encountered	depth	
	from	to
clay	0	20
sand	20	40
pea gravel	40	200
clay	200	220
sandy shale	220	340
fine sand	340	400
good coarse sand	400	470

RECEIVED


NOV 30 1977

DRILLERS REMARKS:

MISS. BD. OF WATER COMM

If well telescopes please sketch and show depths.

GROUND LEVEL

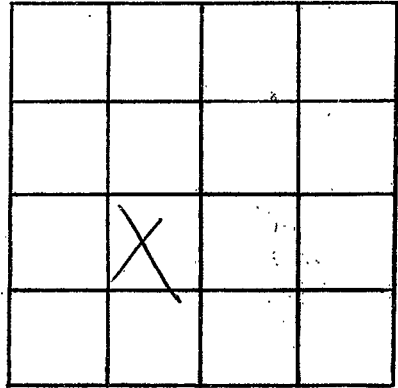

SECTION _____

Please indicate well location X.

ADDITIONAL INFORMATION

If more than one screen,
show locations of each on sketch.