

Wash.  
 F 2007  
 5-24-79

MISSISSIPPI  
 BOARD OF WATER COMMISSIONERS  
 416 North State Street  
 Jackson, Mississippi 39201

WATER WELL DRILLERS LOG

24 May 1979 Lambert Drilling Wash.  
 date well completed firm name county well located

LANDOWNER:  
 John Reed  
 Heland, Miss. (mailing address)

WELL LOCATION:  
 sec 5 T 15 N R 6 E  
 5 miles NE of Heland  
 (distance) (direction) (nearest town)

WELL PURPOSE: none  
 (home, irrigation, municipal, industrial)

- WELL COMPLETION DATA:
- (1) diameter (inches) 4x2
  - (2) total depth (feet) 435
  - (3) static water level (feet) 46 below top of ground.
  - (4) casing PVC 435 (material) (depth)  
 4x2 (size) If telescope see back.
  - (5) screen 20 435-435 (length) (depth to top)  
 2" PVC (size) (material)
  - (6) pump 1/2 26 (HP) (yield gpm)  
 elect (type power)
  - (7) electric log no (yes or no)
- (organization running log)
- (8) how well bottom plugged back press

description of formations encountered	from	to
Sand	0	10
Clay	10	30
Sand & gravel	30	195
Clay	195	210
Rock	210	211
Sand st Clay	211	280
Sand, med	280	310
Clay st Sand	310	360
Sand	360	435

Miss. Board of Water Comm.

SEP 15 1979

RECEIVED

DRILLERS REMARKS:


If well telescopes please sketch and show depths.

GROUND LEVEL

140 4''

415 2''

435 2'' screen

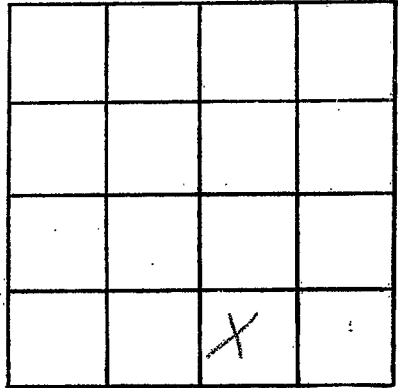

SECTION 5

Please indicate well location X.

ADDITIONAL INFORMATION

If more than one screen, show locations of each on sketch.