

MISSISSIPPI DEPARTMENT OF NATURAL RESOURCES

Bureau of Land and Water Resources

Southport Mall

P.O. Box 10631

Jackson, Mississippi 39209

WATER WELL DRILLERS LOG

WASHINGTON
 F 2011
 6-24-81

6

24 June 1981 Lambert Drilling Wash
 date well completed firm name county well located

LANDOWNER:	description of formations encountered	from	to
James Boufford Leland, Miss. (mailing address)			
WELL LOCATION:	Sand	15	80
sec. 7 T. 18 N. R. 6 E 3 miles NE of Leland (distance) (direction) (nearest town)	gravel	80	120
WELL PURPOSE: <u>DOMC</u> (home, irrigation, municipal, industrial)	Clay	120	280
WELL COMPLETION DATA:	Sand & Clay	280	330
(1) diameter (inches) <u>4 1/2</u>	Rock	330	377
(2) total depth (feet) <u>465</u>	Sand & Gravel	377	425
(3) static water level (feet) <u>28</u> below top of ground.	Sand & Gravel	425	470
(4) casing <u>PVC</u> , <u>445</u> (material) (depth)			
<u>4 1/2</u> If telescope see back. (size)			
(5) screen <u>20</u> , <u>465-445</u> (length) (depth to top)			
<u>2</u> , <u>55</u> (size) (material)			
(6) pump <u>2</u> , <u>30</u> (HP) (yield gpm)			
<u>elect</u> (type power)			
(7) electric log <u>no</u> (yes or no)			
(organization running log)			
(8) how well bottom plugged <u>lead mass.</u>			
DRILLERS REMARKS:			

DEPT. OF NATURAL RESOURCES
 BUREAU OF LAND & WATER RESOURCES

SEP 16 1981

RECEIVED


If well telescopes please sketch and show depths.

GROUND LEVEL

140 - 4 11

#45 - 2 11

465 - 2" 85.

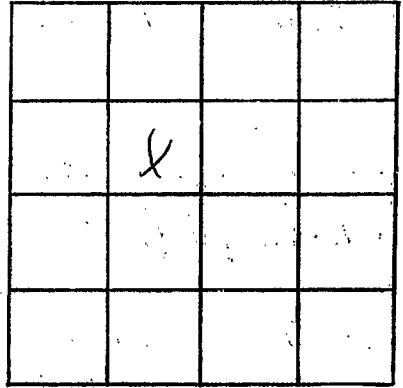

SECTION 7

Please indicate well location X.

ADDITIONAL INFORMATION

If more than one screen,
show locations of each on sketch.