

MISSISSIPPI DEPARTMENT OF NATURAL RESOURCES
 Bureau of Land and Water Resources
 Southport Mall
 P.O. Box 10631
 Jackson, Mississippi 39209
WATER WELL DRILLERS LOG

Washington
F 2012

4-4-83
 date well completed

Schultz Drilling
 firm name

Washington
 county well located

LANDOWNER: Jimmy Reed
Leland, MS

description of formations encountered

from

to

CLAY	0	20
CLAY	20	35
SAND, GRAVEL	35	80

(mailing address)

WELL LOCATION:

sec. 27 T. 18 N. R. 6 E.
4 miles E of Leland
 (distance) (direction) (nearest town)

WELL PURPOSE:

(home, irrigation, municipal, industrial)

WELL COMPLETION DATA:

- (1) diameter (inches) 4"
- (2) total depth (feet) 80'
- (3) static water level (feet) 27' below above top of ground.
- (4) casing APVC, 60'
 (material) (depth)
- (5) screen 20', 60'
 (length) (depth to top)
4" PVC
 (size) (material)
- (6) pump 1 37
 (HP) (yield gpm)
ELE.
 (type power)
- (7) electric log NO
 (yes or no)

(organization running log)

- (8) how well bottom plugged FAP

DRILLERS REMARKS:


DEPT. OF NATURAL RESOURCES
 BUREAU OF LAND & WATER RESOURCES

APR 20 1983

RECEIVED

If well telescopes please
sketch and show depths.

GROUND LEVEL

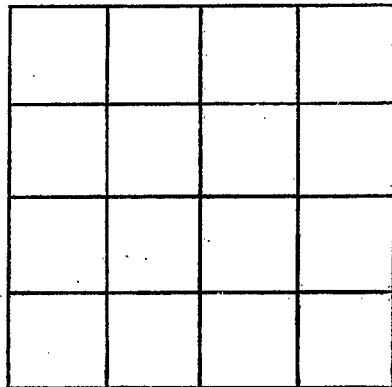

SECTION _____

Please indicate well location X.

ADDITIONAL INFORMATION

If more than one screen,
show locations of each on sketch.