

MISSISSIPPI DEPARTMENT OF NATURAL RESOURCES

Bureau of Land and Water Resources

Southport Mall

P.O. Box 10631

Jackson, Mississippi 39209

WATER WELL DRILLERS LOG

Washington
F 2013

1 May 1983 Lambert Drilling & Cont. Wash.
date well completed firm name county well located

LANDOWNER:	description of formations encountered	from	to
James Wray Leland, Miss. (mailing address)			
WELL LOCATION: sec. 10 T ⁶ N R ¹⁸ E 3 miles E of Leland (distance) (direction) (nearest town)	sand	18	65
WELL PURPOSE: home (home, irrigation, municipal, industrial)	Pea gravel	65	103
WELL COMPLETION DATA:	blue shell	103	126
(1) diameter (inches) 4 1/2	blue clay	126	196
(2) total depth (feet) 365	Clay & sand	196	285
(3) static water level (feet) 24 below top of ground.	rock	285	288
(4) casing PVC, 345 (material) (depth)	sand	288	305
4 1/2 (size) if telescope see back.	sand	305	365
(5) screen 20, 365-345 (length) (depth to top)			
2 (size) PVC (material)			
(6) pump 1 (HP) 20 (yield gpm)			
elect (type power)			
(7) electric log (yes or no)			
(organization running log)			
(8) how well bottom plugged: lower press			
DRILLERS REMARKS:			

DEPT. OF NATURAL RESOURCES
BUREAU OF LAND & WATER RESOURCES
JUL 15 1983
RECEIVED


If well telescopes please sketch and show depths.

GROUND LEVEL

14c 4"

345 2"

345 2" S.C.

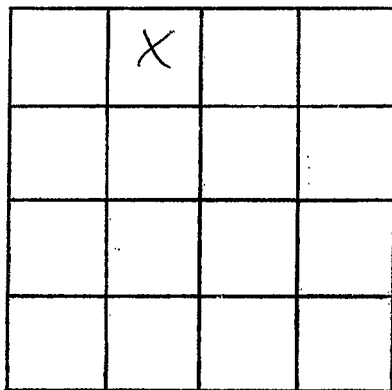

SECTION 1c

Please indicate well location X.

ADDITIONAL INFORMATION

If more than one screen, →
show locations of each on sketch.