

MISSISSIPPI DEPARTMENT OF NATURAL RESOURCES

Bureau of Land and Water Resources

Southport Mall

P.O. Box 10631

Jackson, Mississippi 39209

WATER WELL DRILLERS LOG

WASHINGTON
 F 2014
 5-25-83

5-25 1983 Schultz Drilling Washington
 date well completed firm name county well located

LANDOWNER:	description of formations encountered	from	to
W. W. Stevens Leland MS. (mailing address)			
WELL LOCATION: sec. 5 T. 18 R. 6 E 3 miles NE of Leland (distance) (direction) (nearest town)			
WELL PURPOSE: IRRIGATION (home, irrigation, municipal, industrial)			
WELL COMPLETION DATA:			
(1) diameter (inches) 2"			
(2) total depth (feet) 75'			
(3) static water level (feet) 20' below top of ground.			
(4) casing PVC, 70' (material) (depth)			
(size) if telescope see back.			
(5) screen 5' 70' (length) (depth to top)			
2" PVC (size) (material)			
(6) pump X X (HP) (yield gpm)			
X (type power)			
(7) electric log NO (yes or no)			
(organization running log)			
(8) how well bottom plugged CAP			
DRILLERS REMARKS: OS			


DEPT. OF NATURAL RESOURCES
 BUREAU OF LAND & WATER RESOURCES

JUN - 2 1983

RECEIVED

If well telescopes please sketch and show depths.

GROUND LEVEL

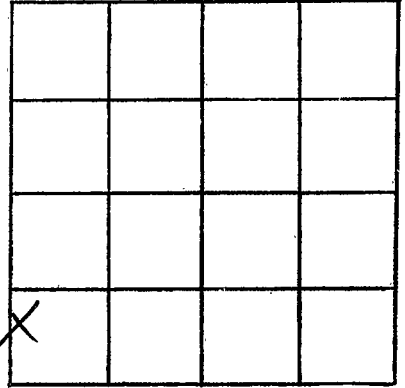

SECTION 5

Please indicate well location X.

ADDITIONAL INFORMATION

If more than one screen,
show locations of each on sketch.