

MISSISSIPPI DEPARTMENT OF NATURAL RESOURCES

Bureau of Land and Water Resources

Southport Mall

P.O. Box 10631

Jackson, Mississippi 39209

WATER WELL DRILLERS LOG

Washington
F 2015

3-1-84 date well completed
Schultz Drilling firm name
Washington county well located


LANDOWNER:	description of formations encountered	from	to
Gus Pieralisi Leland MS (mailing address)			
WELL LOCATION: sec. 35 T 18 N R 6 E 5 miles NE of Leland (distance) (direction) (nearest town)			
WELL PURPOSE: IRRIGATION (home, irrigation, municipal, industrial)			
WELL COMPLETION DATA:			
(1) diameter (inches) 4"			
(2) total depth (feet) 100'			
(3) static water level (feet) 18' below top of ground.			
(4) casing PVC 80' (material) (depth)			
(size) if telescope see back.			
(5) screen 20' 80' (length) (depth to top)			
4" PVC (size) (material)			
(6) pump 3 90 (HP) (yield gpm)			
elk (type power)			
(7) electric log NO (yes or no)			
X (organization running log)			
(8) how well bottom plugged CAP			

DRILLERS REMARKS:

DEPT OF NATURAL RESOURCES
BUREAU OF LAND & WATER RESOURCES
MAR - 6 1984
RECEIVED

If well telescopes please sketch and show depths.

GROUND LEVEL

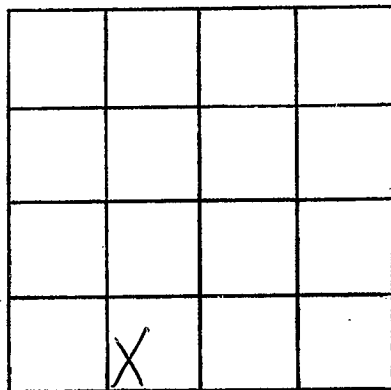

SECTION 35

Please indicate well location X.

ADDITIONAL INFORMATION

If more than one screen,
show locations of each on sketch.