

MISSISSIPPI DEPARTMENT OF NATURAL RESOURCES

Bureau of Land and Water Resources

Southport Mall

P.O. Box 10631

Jackson, Mississippi 39209

WATER WELL DRILLERS LOG

Washington
F 2016


2-21 1984 Schultz Drilling Washington
date well completed firm name county well located

LANDOWNER: Jeff Pieralisi	description of formations encountered	from	to
Leland, MS	CLAY	0	20
(mailing address)	COARSE SAND	20	60
WELL LOCATION:	COARSE SAND and	60	80
sec. 35 T 18 S R 6 E 5 miles NE of Leland (distance) (direction) (nearest town)	PEA GRAVEL		
WELL PURPOSE: IRRIGATION (home, irrigation, municipal, industrial)			
WELL COMPLETION DATA:			
(1) diameter (inches) 2"			
(2) total depth (feet) 80'			
(3) static water level (feet) 18' below top of ground.			
(4) casing PVC 70' (material) (depth)			
(size) if telescope see back.			
(5) screen 10' 70' (length) (depth to top)			
(6) pump 2" PVC (size) (material)			
(7) pump 1 10 (HP) (yield gpm)			
(type power) ele			
(8) electric log NO (yes or no)			
(organization running log) X			
(8) how well bottom plugged CAP			
DRILLERS REMARKS:			

DEPT. OF NATURAL RESOURCES
BUREAU OF LAND & WATER RESOURCES
MAR - 6 1984
RECEIVED

If well telescopes please sketch and show depths.

GROUND LEVEL

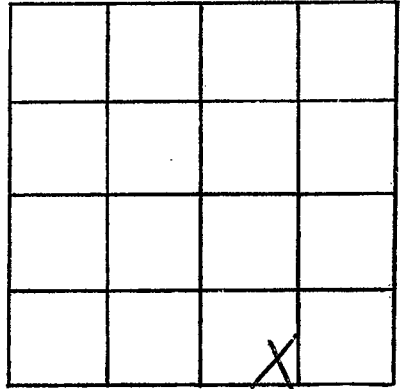

SECTION 35

Please indicate well location X.

ADDITIONAL INFORMATION

If more than one screen, show locations of each on sketch.