

MISSISSIPPI DEPARTMENT OF NATURAL RESOURCES

Bureau of Land and Water Resources

Southport Mall

P.O. Box 10631

Jackson, Mississippi 39209

WATER WELL DRILLERS LOG

F 2017  
 WASHINGTON  
 7-12-84

18 July 84 19 Lambert Drilling Wash.  
 date well completed firm name county well located

LANDOWNER:	description of formations encountered	from	to
Buddy Burgess			
Heland, Miss. (mailing address)	Clay	0	15
WELL LOCATION:	Sand	15	45
sec. 34 T. 18 N. R. 6 E. 8 miles S/E of Heland (distance) (direction) (nearest town)	Sand, coarse	45	90
WELL PURPOSE: home (home, irrigation, municipal, industrial)	Dec. gravel	90	135
WELL COMPLETION DATA:	Clay	135	200
(1) diameter (inches) 4 1/2	Clay st sand	200	350
(2) total depth (feet) 540	Sand	350	400
(3) static water level (feet) 42 below top of ground.	Clay	400	430
(4) casing PVC 510 (material) (depth)	Sand	430	495
4 1/2 (size) if telescope see back.	Sand gravel	495	540
(5) screen 30 540-536 (length) (depth to top)			
2 PVC (size) (material)			
(6) pump 1 20 (HP) (yield gpm)			
elect (type power)			
(7) electric log no (yes or no)			
(organization running log)			
(8) how well bottom plugged back press			
DRILLERS REMARKS:			

RECEIVED  
 APR 19 1985

Department of Natural Resources  
 Bureau of Land & Water Resources


If well telescopes please sketch and show depths.

GROUND LEVEL

140 ————— 4"

510 ————— 2"

540 ————— 2" screen

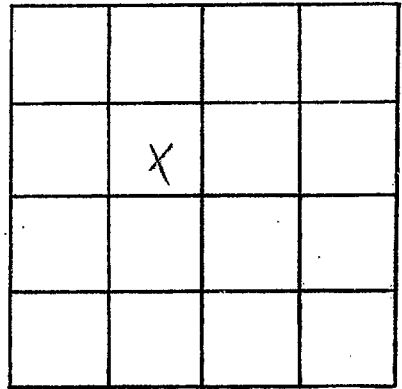

SECTION 34

Please indicate well location X.

ADDITIONAL INFORMATION

If more than one screen,  
show locations of each on sketch.