

MISSISSIPPI DEPARTMENT OF NATURAL RESOURCES

Bureau of Land and Water Resources

Southport Mall

P.O. Box 10631

Jackson, Mississippi 39209

WATER WELL DRILLERS LOG

Washington
F 2018

date well completed June 21 1985 well name Lamp's well & pump county well located Washington

LANDOWNER: Robert Ratzloff

description of formations encountered	from	to
<u>Sand</u>	<u>450</u>	<u>470</u>

Leland, ms
 (mailing address)

WELL LOCATION:
 sec. 33 T. 18N S. R. 6 E. #1
5 miles S.E. of Leland
 (distance) (direction) (nearest town)

WELL PURPOSE:
 (home, irrigation, municipal, industrial)

- WELL COMPLETION DATA:
- (1) diameter (inches) 4 1/2"
 - (2) total depth (feet) 470'
 - (3) static water level (feet) 23' below top of ground.
 - (4) casing PVC, 460' (material) (depth)
462 (size) if telescope see back.
 - (5) screen 30, 460 to 470 (length) (depth to top)
2.000, PVC (size) (material)
 - (6) pump 1, 15 (HP) (yield gpm)
220 (type power)
 - (7) electric log no (yes or no)
(organization running log)
 - (8) how well bottom plugged Shark

DEGEN
 INC.

MAY 11 1985

Department of Natural Resources
 Bureau of Land & Water

DRILLERS REMARKS:


If well telescopes please sketch and show depths.

GROUND LEVEL

120' 4" PVC

340' 9" PVC

30' 2" PVC

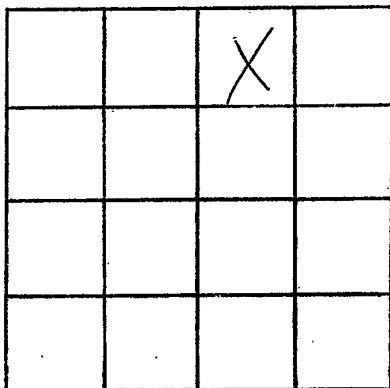

SECTION 33

Please indicate well location X.

ADDITIONAL INFORMATION

If more than one screen, show locations of each on sketch.