

MISSISSIPPI DEPARTMENT OF NATURAL RESOURCES

Bureau of Land and Water Resources

Southport Mall

P.O. Box 10631


Jackson, Mississippi 39209

WATER WELL DRILLERS LOG

WASHINGTON
F 2000

26 Apr 1986 date well completed
86 Lambert Drilling firm name
Wash county well located

LANDOWNER:	description of formations encountered	from	to
David Lewis Leland, Miss (mailing address)			
WELL LOCATION:	Sand	15	90
sec. 84 T. 18 N. R. 6 E 8 miles SW of Leland (distance) (direction) (nearest town)	fine gravel	70	122
WELL PURPOSE: none (home, irrigation, municipal, industrial)	Clay	122	180
WELL COMPLETION DATA:	Clay + Sand	180	255
(1) diameter (inches) 4x2	Sand	255	280
(2) total depth (feet) 435	Clay	280	340
(3) static water level (feet) 35 below top of ground.	Sand	340	435
(4) casing PVC, 405 (material) (depth) 4x2 (size) if telescope see back.			
(5) screen 30 (length), 435-405 (depth to top) 2 (size), PVC (material)			
(6) pump 1/2 (HP), 28 (yield gpm) eled (type power)			
(7) electric log (yes or no) (organization running log)			
(8) how well bottom plugged beds closed			
DRILLERS REMARKS:			

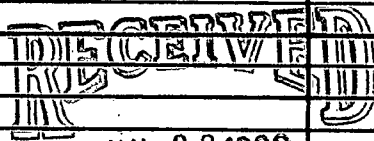

Department of Natural Resources
Bureau of Land & Water Resources

If well telescopes please sketch and show depths.

GROUND LEVEL

4" — 140

2" — 405

2" 50" — 435

X			

SECTION 34

Please indicate well location X.

ADDITIONAL INFORMATION

If more than one screen, show locations of each on sketch.