

MISSISSIPPI DEPARTMENT OF ENVIRONMENTAL QUALITY
Bureau of Land and Water Resources

P. O. Box 10631
Jackson, MS 39289-0631
WATER WELL DRILLERS LOG

COUNTY WELL LOCATED Washington	
WELL NUMBER F	CODED
DATE WELL COMPLETED 2037 3-21-91	

PERMIT NUMBER MSGW 13386
NAME OF DRILLING FIRM IRRIGATION EQUIPMENT
601/887-2555

NAME & MAILING ADDRESS OF LANDOWNER MOBILE, MS Holly Ridge Planting P.O. BOX 95 Holly Ridge, MS		
WELL LOCATION: SEC	TOWNSHIP	RANGE
24	18	6
DISTANCE	DIRECTION	NEAREST TOWN
4 Miles	South	of Holly Ridge
OTHER LANDMARK		
WELL PURPOSE: Home, Irrigation, Municipal, Industrial, Fish Pond, etc. Irrigation - Pivot		


PUMP DATA		
PUMP TYPE (Circle One): Submersible, <u>turbine</u> Jet Flowing Well, Other (Describe) _____		
POWER TYPE (Circle One): Electric, Tractor, <u>Diesel</u> Gasoline Butane, Other (Describe) _____ H/P 40		
Pump Capacity (GPM) 900	No. of Stages 2	Setting Depth 50 FT.
PUMP TEST		
Well yielded _____ GPM with a drawdown of _____ ft. after _____ hours of pumping		

WELL DATA		
Well Depth 115	Casing Diameter (In.) 12	Casing Length (Ft.) 75
Type of Casing Steel	Hole Depth 115	Depth to Static Water Level 23'
TYPE OF COMPLETION: (Circle One or More): <u>Gravel Packed</u> Underreamed, Telescoped, Natural Development, Open Hole, Other		
Top of Lap Pipe or Reduction in Casing		
FEET	IF TELESCOPED OR MORE THAN ONE SCREEN: USE BACK PAGE	

LOG DATA	
TYPE OF LOG RUN (Circle One): Electric, Gamma Ray, Density, Sonic, Neutron, Other (Describe) _____ No Log Run,	
Name of Organization Running Log	

SCREEN DATA		
Diameter - Inches 12	Length - Feet 40	Slot Size - Inches .060
Screen Type Steel	Depth to Bottom - Feet 115	


GEOLOGIC DATA (Office Use Only)			
Surface Elev.	Geologic Unit	Unit Thickness	Depth to Top
Subs. SWL	Date	Analysis	Aquifer Test
Driller's Remarks Big-D Pivot			

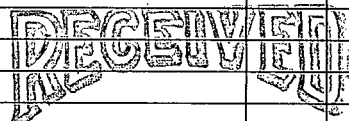DESCRIPTION OF FORMATIONS ENCOUNTERED	FROM	TO	FORMATIONS (Continued)	FROM	TO
Clay	0	15	 APR 01 1991 Dept. of Environmental Quality Bureau of Land & Water Resources		
Fine SAND + Clay	15	25			
Fine SAND	25	45			
medium SAND	45	55			
medium COARSE SAND	55	75			
COARSE SAND + GRAVEL	75	85			
medium SAND	85	95			
COARSE SAND + GRAVEL	95	115			

IF MORE SPACE IS NEEDED, USE BACK

If well telescopes please sketch and show depths.

GROUND LEVEL

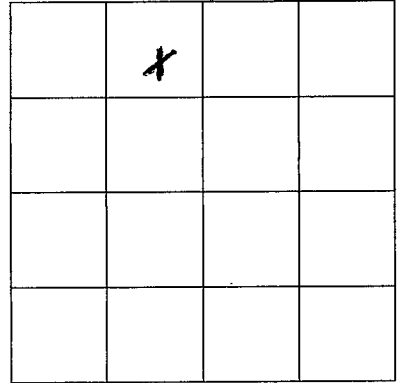

SECTION

24

Please indicate well location X.

ADDITIONAL INFORMATION

If more than one screen,
show location of each on sketch.