

MISSISSIPPI DEPARTMENT OF ENVIRONMENTAL QUALITY

Office of Land and Water Resources

P. O. Box 10631
Jackson, MS 39289-0631
WATER WELL DRILLERS LOG

COUNTY WELL LOCATED <i>Wash</i>	
WELL NUMBER <i>F</i>	CODED
DATE WELL COMPLETED <i>2029</i> <i>5 May 93</i>	

PERMIT NUMBER
NAME OF DRILLING FIRM <i>Lambert Drilling</i>

NAME & MAILING ADDRESS OF LANDOWNER <i>Susan Buckner</i> <i>Leland, ms.</i>			
WELL LOCATION:	SEC	TOWNSHIP	RANGE
	<i>10</i>	<i>18 N</i>	<i>6 E</i>
DISTANCE	DIRECTION	NEAREST TOWN	
<i>6</i> Miles	<i>E</i>	of <i>Leland</i>	
OTHER LANDMARK			
WELL PURPOSE: Home, Irrigation, Municipal, Industrial, Fish Pond, etc. <i>home</i>			

PUMP DATA		
PUMP TYPE (Circle One): Submersible, Turbine, Jet, Flowing Well, Other (Describe) _____		
POWER TYPE (Circle One): Electric, Tractor, Diesel, Gasoline, Butane, Other (Describe) _____ H/P <i>1</i>		
Pump Capacity (GPM) <i>20</i>	No. of Stages <i>8</i>	Setting Depth <i>105</i> FT.
PUMP TEST		
Well yielded _____ GPM with a drawdown of _____ ft. after _____ hours of pumping		

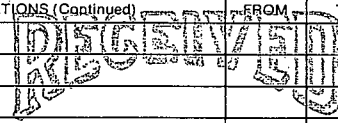
WELL DATA		
Well Depth <i>400</i>	Casing Diameter (In.) <i>4x2</i>	Casing Length (Ft.) <i>380</i>
Type of Casing <i>PVC</i>	Hole Depth <i>400</i>	Depth to Static Water Level <i>52</i>
TYPE OF COMPLETION: (Circle One or More): Gravel Packed, Underreamed, Telescoped, Natural Development, Open Hole, Other (Describe) _____		

LOG DATA	
TYPE OF LOG RUN (Circle One): Electric, Gamma Ray, Density, Sonic, Neutron, Other (Describe) _____	
Name of Organization Running Log	

WELL GROUTED TO A DEPTH OF _____ FEET Type Grout (circle one): Cement, Bentonite, or Mix

GEOLOGIC DATA (Office Use Only)			
Surface Elev.	Geologic Unit	Unit Thickness	Depth to Top
Subs. SWL	Date	Analysis	Aquifer Test
Driller's Remarks			

SCREEN DATA		
Diameter - Inches <i>2"</i>	Length - Feet <i>20</i>	Slot Size - Inches <i>.010</i>
Screen Type <i>PVC rapped</i>	Depth to Bottom - Feet <i>380-400</i>	

DESCRIPTION OF FORMATIONS ENCOUNTERED	FROM	TO	FORMATIONS (Continued)	FROM	TO
<i>Mixed</i>	<i>0</i>	<i>10</i>	 JUL 22 1993 Dept. of Environmental Quality Office of Land & Water Resources		
<i>sand</i>	<i>10</i>	<i>80</i>			
<i>gravel</i>	<i>80</i>	<i>190</i>			
<i>clay</i>	<i>190</i>	<i>220</i>			
<i>sand</i>	<i>220</i>	<i>400</i>			

IF MORE SPACE IS NEEDED, USE BACK

If well telescopes please sketch and show depths.

GROUND LEVEL

4" 140

2" 380

2" 400 501

		X	

SECTION 10

Please indicate well location X.

ADDITIONAL INFORMATION

If more than one screen, show location of each on sketch.