

B2197

Washington
 CL-1192
 G-

MISSISSIPPI
 BOARD OF WATER COMMISSIONERS
 416 North State Street
 Jackson, Mississippi 39201

WATER WELL DRILLERS LOG

CODED

12-1-79 date well completed Layne Central Company firm name Washington county well located

LANDOWNER:	description of formations encountered	from	to
Ballard Farms			
Arcola, MS	Sand	18	48
(mailing address)	Coarse Sand	48	56
WELL LOCATION:	Coarse Sand & Gravel	56	90
29 sec. T 17 N S			
8 R E W			
6 miles N.W. of Arcola			
(distance) (direction) (nearest town)			
WELL PURPOSE: Irrigation			
(home, irrigation, municipal, industrial)			
WELL COMPLETION DATA:			
(1) diameter (inches) 12"			
(2) total depth (feet) 90'			
(3) static water level (feet) 11' below top of ground.			
(4) casing Steel 59' (material) (depth)			
12" (size) If telescope see back.			
(5) screen 30' 60' (length) (depth to top)			
10" Steel (size) (material)			
(6) pump 20 1000 (HP) (yield gpm)			
Butane (type power)			
(7) electric log No (yes or no)			
(organization running log)			
(8) how well bottom plugged Plate			
DRILLERS REMARKS:			

CODED


DEPT. OF NATURAL RESOURCES
 BUREAU OF LAND & WATER RESOURCES

JAN 18 1980

RECEIVED

If well telescopes please sketch and show depths.

GROUND LEVEL

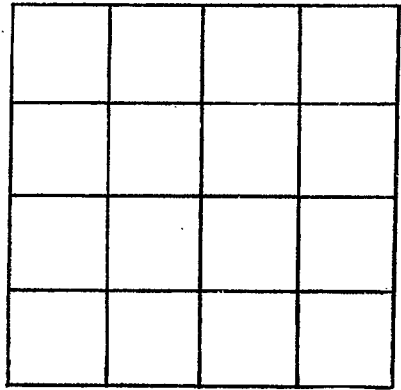

SECTION _____

Please indicate well location X.

ADDITIONAL INFORMATION

A series of horizontal lines for recording additional information, starting below the 'ADDITIONAL INFORMATION' header and extending to the bottom of the page.

If more than one screen, show locations of each on sketch.