

WASH.  
6  
7-9-74

MISSISSIPPI  
BOARD OF WATER COMMISSIONERS  
416 North State Street  
Jackson, Mississippi 39201

CODED

WATER WELL DRILLERS LOG

July 9 1974 Schultz Drilling Wash  
date well completed firm name county well located

LANDOWNER:	description of formations encountered	from	to
Rt 2 Cottonville Miss (mailing address)	clay	0	23
WELL LOCATION: sec 31 T 17 R 8 4 miles E of Nayside (distance) (direction) (nearest town)	sand	23	70

WELL PURPOSE: Home  
(home, irrigation, municipal, industrial)

- WELL COMPLETION DATA:
- (1) diameter (inches) 2
  - (2) total depth (feet) 65
  - (3) static water level (feet) 12 below top of ground
  - (4) casing P.V.C. (material) (depth)  
(size) if telescope see back.
  - (5) screen 5 (length) (depth to top)  
2 (size) (material)
  - (6) pump 1/2 (HP) 9 (yield gpm)  
Elev (type power)
  - (7) electric log Yes (yes of no)  
(organization running log)
  - (8) how well bottom plugged Plug


DRILLERS REMARKS:

DISCONTINUED  
DEC 19 1974

MISS. BD. OF WATER COMMISSIONERS

If well telescopes please sketch and show depths.

GROUND LEVEL

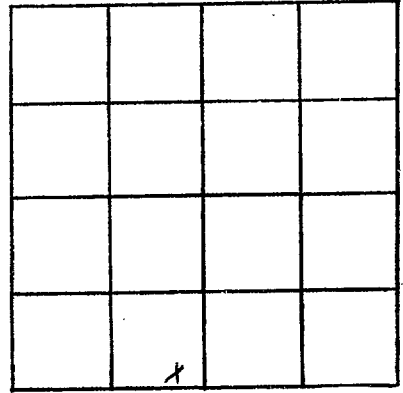

SECTION 31

Please indicate well location X.

ADDITIONAL INFORMATION

If more than one screen,  
show locations of each on sketch.