

MISSISSIPPI DEPARTMENT OF NATURAL RESOURCES

Bureau of Land and Water Resources

Southport Mall

P.O. Box 10631

Jackson, Mississippi 39209

WATER WELL DRILLERS LOG

CODED

Washington
G

4-15-1985 date well completed Schultz Drilling firm name Washington county well located

LANDOWNER:	description of formations encountered	from	to
Swiftwater Bapt. Church	CLAY SAND CLAY SHALE SAND	0	18
Greenville MS		18	90
(mailing address)		90	160
WELL LOCATION:		160	360
sec. 25 T 17 N R 8 E		360	410
3 miles S of Greenville			
(distance) (direction) (nearest town)			
WELL PURPOSE: church			
(home, irrigation, municipal, industrial)			
WELL COMPLETION DATA:			
(1) diameter (inches) 4" x 2"			
(2) total depth (feet) 410'			
(3) static water level (feet) 36' below above top of ground.			
(4) casing PVC 390' (material) (depth)			
(size) if telescope see back.			
(5) screen 20' 390' (length) (depth to top)			
2" PVC (size) (material)			
(6) pump 1 20 (HP) (yield gpm)			
ele (type power)			
(7) electric log NO (yes or no)			
X (organization running log)			
(8) how well bottom plugged b/w			

CODED



RECEIVED

DEC 2 - 1985

DRILLERS REMARKS:

Department of Natural Resources
 Bureau of Land & Water Resources

If well telescopes please sketch and show depths.

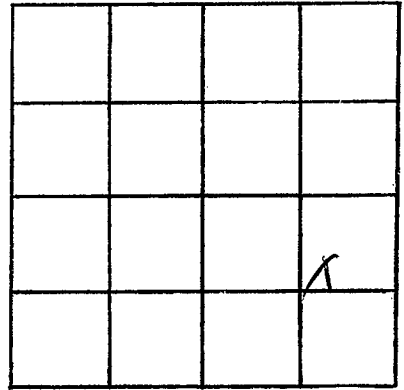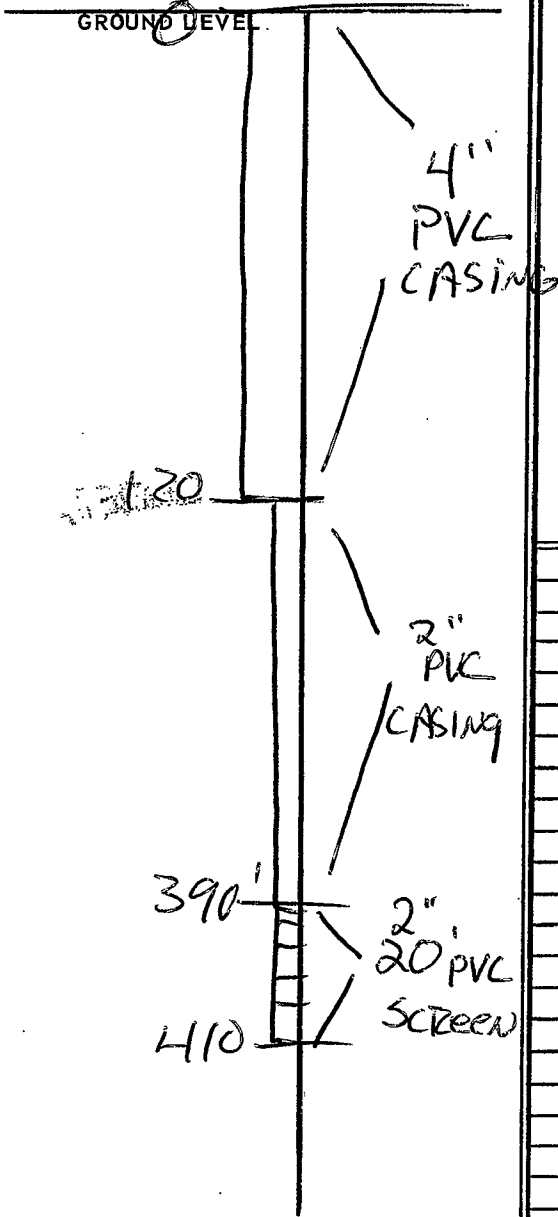

SECTION 25

Please indicate well location X.

ADDITIONAL INFORMATION

If more than one screen, show locations of each on sketch.