

MISSISSIPPI DEPARTMENT OF NATURAL RESOURCES

Bureau of Land and Water Resources

Southport Mall

P.O. Box 10631

Jackson, Mississippi 39209

WATER WELL DRILLERS LOG

CODED

WASHINGTON  
G

4-21-85 Scholtz Drilling WASH.  
date well completed firm name county well located

LANDOWNER: C.A. Durrell  
Wilcox Road  
Greenville, MS  
(mailing address)

description of formations encountered	from to	
	feet	feet
CLAY	0	31
SAND	31	88

WELL LOCATION:  
sec 20 T 17 N R 8 E  
4 miles S of Greenville  
(distance) (direction) (nearest town)

WELL PURPOSE: IRRIGATION  
(home, irrigation, municipal, industrial)

CODED

WELL COMPLETION DATA:


- (1) diameter (inches) 16"
- (2) total depth (feet) 88'
- (3) static water level (feet) 32' below top of ground.
- (4) casing PVC, 58' (material) (depth)  
(size) if telescope see back.
- (5) screen 30' 58' (length) (depth to top)  
16" PVC (size) (material)
- (6) pump 40 1200 (HP) (yield gpm)  
ele (type power)
- (7) electric log NO (yes or no)  
(organization running log) CAP
- (8) how well bottom plugged

RECEIVED  
DEC 3 - 1985

DRILLERS REMARKS:

If well telescopes please sketch and show depths.

GROUND LEVEL

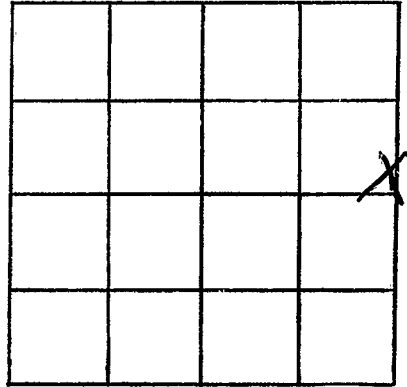

SECTION 20

Please indicate well location X.

ADDITIONAL INFORMATION

If more than one screen,  
show locations of each on sketch.