

Washington  
 G 40  
 10-67  
 Elec Log

MISSISSIPPI  
 BOARD OF WATER COMMISSIONERS  
 416 North State Street  
 Jackson, Mississippi 39201

02539

WATER WELL DRILLERS LOG

October 1, 1967 Layne-Central Company Washington  
 date well completed firm name county well located

LANDOWNER: National Packing Company  
 Greenville, Mississippi  
 (mailing address)


WELL LOCATION:  
 sec 14 T 17 N R 9  
 XX W  
 6 miles southwest of Greenville  
 (distance) (direction) (nearest town)

WELL PURPOSE: industrial  
 (home, irrigation, municipal, industrial)

WELL COMPLETION DATA:

- (1) diameter (inches) 10x6
- (2) total depth (feet) 572
- (3) static water level (feet) 63 below top of ground.
- (4) casing steel 521 (material), (depth)  
 10" if telescope see back. (size)
- (5) screen 40' 561' bottom (length), (depth to top)  
 6" Stainless Steel (size), (material)
- (6) pump 40 500 (HP), (yield gpm)  
 electric (type power)
- (7) electric log yes (yes or no)  
 U.S.G.S. #58 (organization running log)
- (8) how well bottom plugged B.P.V.


description of formations encountered	from	to
Clay	0	26
Sand	26	65
Coarse sand, pea gravel	65	94
Clay	94	106
Rock	106	109
Hard clay	109	115
Sandy clay	115	170
Shale	170	179
Sandy clay	179	474
Sand strks.	474	489
Sandy shale	489	507
Sand "white rock"	507	568
Shale	568	572
Pollon, shale		572

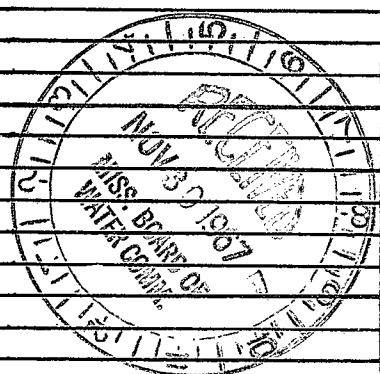

DRILLERS REMARKS: 61' of 6" casing (lap). 6' 9" B.P.V.  
 4' 3" space between casing and screen.

If well telescopes please sketch and show depths.

GROUND LEVEL

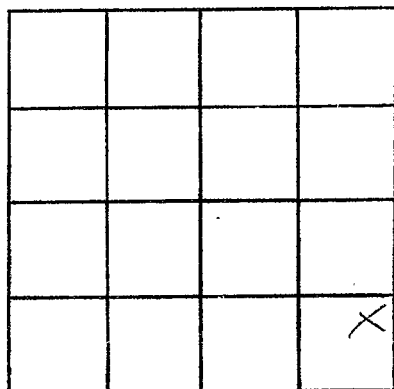

SECTION 14

Please indicate well location X.

ADDITIONAL INFORMATION

If more than one screen,  
show locations of each on sketch.