

WASH.
G45
7-28-60

G-250

WATER WELL DRILLERS LOG

Date: 7/28, 1960, Driller: Bailey Drilling Co County Washington
(Name)

"STUCKEYS"
 (1) Owner of Land: Kinchan O'Keefe
 (Name)
Greenville, Miss.
 (Address)

(2) Location: 1/4, 1/4, Sec. 6 T. R.
0 miles SW of Greenville
 (distance) (direction) (Nearest Town)

(3) Topography: Level
 (Hilly) (Flat) (Level)

(4) Purpose of Well: Domestic
 (Domestic Irrigation
 Municipal, Industrial, Other)

Description & Color of Materials Sand, Clay, Red Clay, Shell, etc.	Thick- ness Feet	Depth Feet
Clay	20	20
Sand	62	82
Gravel	28	110
Mud	139	249
Rocks	3	252
Mud	27	279
Sand + Mud	6	285
Sand	33	318

Information upon completion of well:

(1) Diameter 4 X 2 1/2 inches

(2) Total Depth 316 feet.

(3) Water Level 30 feet below top of ground.

(4) Cased to 286, Size 4 X 2 1/2


(5) Screen: Size 2", Length 30'

(6) Were any formations sealed against pollution?
 _____ yes, X no.

If YES depth of formation _____

Why _____

Drillers Remarks: _____

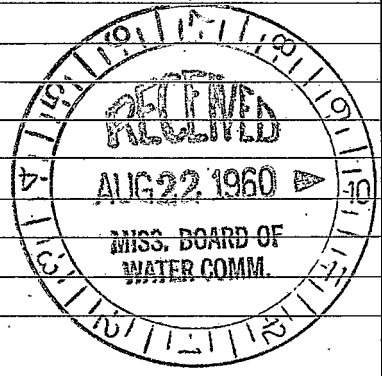

(Use Back Side)

Well

