


G49
 6-2-66

WATER WELL DRILLERS LOG

Date: 6/2, 1966, Driller: Bailey Drlg Co County: Washington
 (Name)

	Description & Color of Materials Sand, Clay, Red Clay, Shell, etc.	Thick- ness Feet	Depth Feet	
(1) Owner of Land: <u>Mr. W.D. Gustine</u> (Name) <u>Greenville, Miss.</u> (Address)	Clay		30	
(2) Location: $\frac{1}{4}$, <u>SW</u> $\frac{1}{4}$, Sec. <u>9</u> T. <u>17</u> R. <u>E</u> <u>1</u> miles <u>S</u> of <u>Greenville</u> (distance) (direction) (Nearest Town)	Sand Gravel Mud Rock		60 75 212 212 1/2	
(3) Topography: <u>Flat</u> (Hilly) (Flat) (Level)	Mud Rock		360 360 1/2	
(4) Purpose of Well: <u>Domestic</u> (Domestic Irrigation Municipal, Industrial, Other)	Mud		415	
Information upon completion of well:	Rock		416	
	Mud		422	
	Rock		423	
	Mud		425	
	Rock		425 1/2	
	(1) Diameter <u>4 X 2</u> inches.	Mud + Sand		450
	(2) Total Depth <u>540</u> feet.	Rock		450 1/2
	(3) Water Level <u>43</u> feet below top of ground.	Mud + Sand		471
	(4) Cased to <u>all way</u> size <u>4 X 2</u>	Mud		577
	(5) Screen: Size <u>2"</u> , Length <u>20"</u>	Sand		540
(6) Were any formations sealed against pollution? <u>no</u>				
If YES depth of formation _____				
Why _____				
Drillers Remarks: _____				

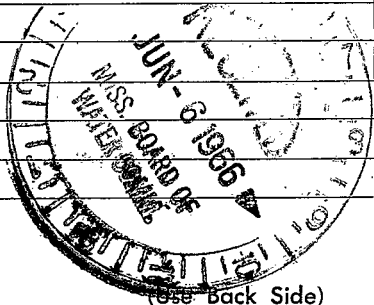

Well No.

