

Washington
 G 50
 1-68

MISSISSIPPI
 BOARD OF WATER COMMISSIONERS
 416 North State Street
 Jackson, Mississippi 39201

WATER WELL DRILLERS LOG

29 Jan 68 19 date well completed
 Delta Pump & Water Works Wash. firm name
 county well located

LANDOWNER:
 City of Greenville
 Greenville, Miss.
 (mailing address)

description of formations encountered	from	to
mixed	0	15
clay	15	75
Sand & Gravel	75	125
blue clay	125	175
Red clay	175	185
mixed Red & White clay	185	190
Shale	190	295
Sand	295	358
blue clay	358	360

WELL LOCATION:
 sec. 6 T. 17 N. R. 9 E.
 S. W. of Greenville
 (distance) (direction) (nearest town)

WELL PURPOSE: Shop & Off.
 (home, irrigation, municipal, industrial)

WELL COMPLETION DATA:

(1) diameter (inches) 2"

(2) total depth (feet) 360

(3) static water level (feet) 306" below top of ground.

(4) casing Steel, 351, (material) (depth)

if telescope see back. (size)

(5) screen 10', 351 (length) (depth to top)

2", Stainless Steel (size) (material)


(6) pump 1, 950 ? (9.50 gpm) (HP) (yield gpm)

Elect (type power)

(7) electric log (yes or no)

(organization running log)


(8) how well bottom plugged Steel plug

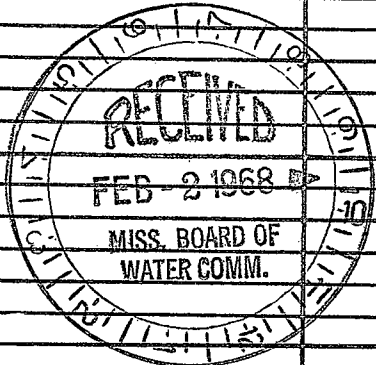

DRILLERS REMARKS:

If well telescopes please sketch and show depths.

GROUND LEVEL

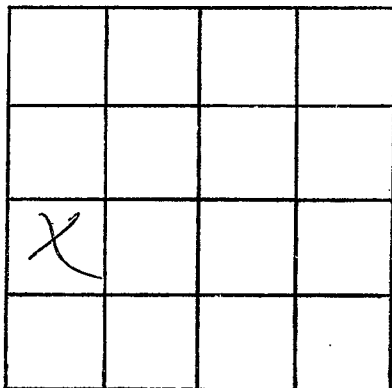

SECTION 65

Please indicate well location X.

ADDITIONAL INFORMATION

If more than one screen,
show locations of each on sketch.