

WASHINGTON
G54
4-14-72

MISSISSIPPI
BOARD OF WATER COMMISSIONERS
416 North State Street
Jackson, Mississippi 39201

WATER WELL DRILLERS LOG

CODED
126570663

April 14, 1972 Singer-Layne Central Division Washington
date well completed firm name county well located

LANDOWNER: Dycus Bros. Fish Farm	description of formations encountered	from	to
	Clay	0	30
	Coarse sand	30	60
Greenville, Mississippi (mailing address)	Gravel and sand	60	73
	Clay		73
WELL LOCATION:			
sec. 28 T 17 N R 8 W			
6 miles south of Greenville (distance) (direction) (nearest town)			
WELL PURPOSE: Irrigation (home, irrigation, municipal, industrial)			
WELL COMPLETION DATA:			
(1) diameter (inches) 12			
(2) total depth (feet) 73			
(3) static water level (feet) 25' below top of ground.			
(4) casing steel 53' (material) (depth)			
12" if telescope see back. (size)			
(5) screen 20' 73' (length) (depth to top)			
12" Armco (size) (material)			
(6) pump 7-1/2 500 (HP) (yield gpm)			
electric (type power)			
(7) electric log no (yes or no)			
(organization running log)			
(8) how well bottom plugged plate			
DRILLERS REMARKS:			


CODED

MAY 16 1972

MISS. DIV. OF
WATER RESOURCES

If well telescopes please sketch and show depths.

GROUND LEVEL

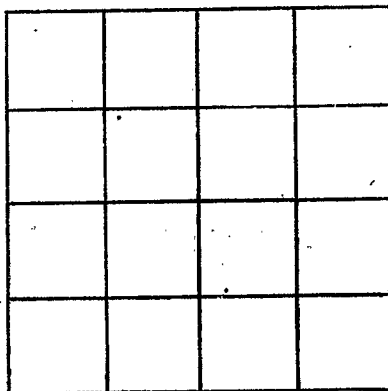

SECTION _____

Please indicate well location X.

ADDITIONAL INFORMATION

If more than one screen,
show locations of each on sketch.