

G56  
7-31-62

WATER WELL DRILLERS LOG

CODED

Date: 7/31, 1962, Driller: Bailey Drilling Co. County: Washington  
(Name)

(1) Owner of Land: H. F. Council  
(Name)  
Greenville, Miss.  
(Address)

(2) Location: NE 1/4, SW 1/4, Sec. 10 T7R8,  
2 miles South of Greenville  
(distance) (direction) (Nearest Town)

(3) Topography: Flat  
(Hilly) (Flat) (Level)

(4) Purpose of Well: Cattle  
(Domestic Irrigation  
Municipal, Industrial, Other)

Description & Color of Materials Sand, Clay, Red Clay, Shell, etc.	Thick- ness Feet	Depth Feet
Clay	30	30
Sand	30	60
Gravel	12	72

CODED

Information upon completion of well:

(1) Diameter 2 inches.

(2) Total Depth 72 feet.

(3) Water Level 14 feet below top of ground.

(4) Cased to all way Size 2


(5) Screen: Size 2, Length 5

(6) Were any formations sealed against pollution?  
yes,  no.

If YES depth of formation \_\_\_\_\_

Why \_\_\_\_\_

Drillers Remarks: \_\_\_\_\_

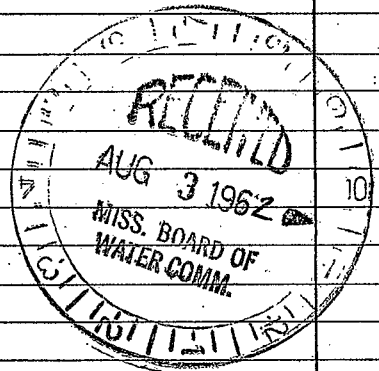

Well No.

(Use Back Side)

10/10/50

Dear Mr. [Name]

I have your letter of the 10th and am sorry to hear that you are having trouble with the [subject].

The [subject] is a very important part of our business and we will do our best to solve the problem as quickly as possible.

I have discussed this with the [department] and we have decided to [action].

I am sure that this will resolve the issue and I will contact you again once the matter is settled.

Thank you for your patience and understanding.

Sincerely,  
[Name]

[Title]

[Company Name]

[Address]

[City, State, Zip]

[Phone Number]

[Fax Number]

[Email Address]

[Website]