

WASH.

MISSISSIPPI BOARD OF WATER COMMISSIONERS

DG57

10-19-62

WATER WELL DRILLERS LOG

CODED

Date: 10/19, 1962, Driller: Baley Drilling Co.
(Name)

County: Washington

(1) Owner of Land: H T Council
(Name)
Greenville, Miss.
(Address)

Description & Color of Materials
Sand, Clay, Red Clay, Shell, etc.

Thick-
ness
Feet

Depth
Feet

Clay
Sand

25
68

(2) Location: NE 1/4, SW 1/4, Sec. 10 T17R8,
2 miles South, of Greenville
(distance) (direction) (Nearest Town)

(3) Topography: Flat
(Hilly) (Flat) (Level)

(4) Purpose of Well: Domestic
(Domestic Irrigation
Municipal, Industrial, Other)

CODED

Information upon completion of well:

(1) Diameter 2 inches.

(2) Total Depth 68 feet.

(3) Water Level 12 feet below top of ground.

(4) Cased to all way, Size 2


(5) Screen: Size 2, Length 5ft.

(6) Were any formations sealed against pollution?
no.

If YES depth of formation _____

Why _____

Drillers Remarks: _____

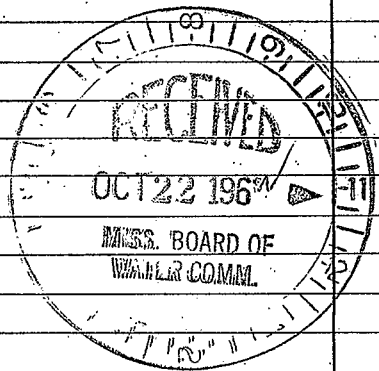

Well No.

(Use Back Side)

SECRET

[Faint, mostly illegible text covering the majority of the page. The text appears to be a document or report with several paragraphs, but the characters are too light to transcribe accurately.]

MEMORANDUM FOR THE DIRECTOR

Very truly yours,

[Signature]

[Name]

[Title]