

WASH.  
 G58  
 7-8-64

WATER WELL DRILLERS LOG

**CODED**

Date: 7/8, 1964, Driller: Bailey, Wm. B. County: Washington  
 (Name)


(1) Owner of Land:	Description & Color of Materials Sand, Clay, Red Clay, Shell, etc.	Thick- ness Feet	Depth Feet
<u>H. I. Council</u> (Name) <u>Greenville, Miss.</u> (Address)	<u>Clay</u>		<u>20</u>
(2) Location: <u>NE 1/4, SW 1/4, Sec. 10 T17R8</u>	<u>Sand</u>		<u>60</u>
<u>2</u> miles <u>S</u> , of <u>Greenville</u> (distance) (direction) (Nearest Town)	<u>Gravel</u>		<u>75</u>
(3) Topography: <u>Flat</u> (Hilly) (Flat) (Level)			
(4) Purpose of Well: <u>Irrigation</u> (Domestic Irrigation Municipal, Industrial, Other)			

**CODED**

Information upon completion of well:

- (1) Diameter 16 inches.
- (2) Total Depth 75 feet.
- (3) Water Level 13 feet below top of ground.
- (4) Cased to all way, Size 16
- (5) Screen: Size 16, Length 50 ft
- (6) Were any formations sealed against pollution?  
 \_\_\_\_\_ yes, X no.

If YES depth of formation \_\_\_\_\_  
 Why \_\_\_\_\_  
 Drillers Remarks: \_\_\_\_\_

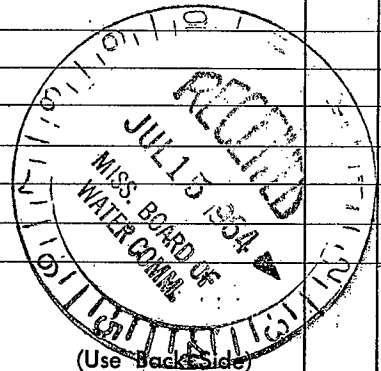

Well No.

(Use Back Side)

1870

1871

1872

1873

1874

1875

1876