

WASH.

G59

8-20-60

WATER WELL DRILLERS LOG

Date: 8/20, 1960, Driller: Bailey Drilling Co (Name) County: Washington

(1) Owner of Land: James Petty (Name)  
Greenville, Miss. (Address)

(2) Location: 1/4, 1/4, Sec. 4 17 N 8 W T. R.  
8 miles South of Greenville (distance) (direction) (Nearest Town)

(3) Topography: Level (Hilly) (Flat) (Level)

(4) Purpose of Well: Domestic (Domestic Irrigation) (Municipal, Industrial, Other)

Description & Color of Materials Sand, Clay, Red Clay, Shell, etc.	Thick- ness Feet	Depth Feet
Clay	41	41
Sand	34	75
Gravel	32	107
Sand + Mud	53	160
Sand	41	201
Mud	16	217
Sand	10	227
Mud	2	229
Sand	10	239
Mud	24	263
Sand (fine)	20	283
Mud	3	286
Sand (fine)	13	299
Mud	6	303
Sand	27	330

Information upon completion of well:

(1) Diameter 4 X 2 inches.

(2) Total Depth 325 feet.

(3) Water Level 21 feet below top of ground.

(4) Cased to 307, Size 4 X 2


(5) Screen: Size 2" Length 18"

(6) Were any formations sealed against pollution?  
yes, X no.

If YES depth of formation \_\_\_\_\_

Why \_\_\_\_\_

Drillers Remarks: \_\_\_\_\_

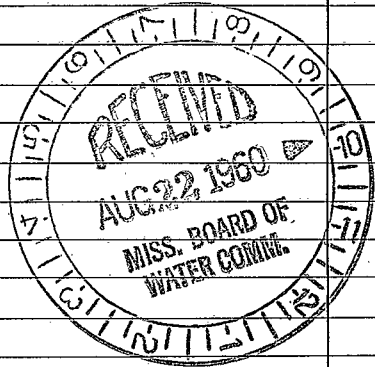

(Use Back Side)

Well No.

