

660

11-16-61

WATER WELL DRILLERS LOG

Date: 11/16, 1961, Driller: Bailey & Co., County: Washington

(1) Owner of Land:	Description & Color of Materials	Thick-ness Feet	Depth Feet
Ted Witherspoon (Name) Greenville, Miss. (Address) Swiftwater	Clay	40	40
(2) Location: 1/4, 1/4, Sec. 13 T. R.	Sand	40	80
4 miles South of Greenville (distance) (direction) (Nearest Town)	Mud	40	120
(3) Topography: Flat (Hilly) (Flat) (Level)	Sand	20	140
(4) Purpose of Well: Domestic (Domestic Irrigation Municipal, Industrial, Other)	Mud	34	154
	Sand	36	190
	6" Rock at 340		
	18" " " 370		

Information upon completion of well:


- (1) Diameter 3x2 inches.
- (2) Total Depth 475 feet.
- (3) Water Level 26 feet below top of ground.
- (4) Cased to all way size 3x2.
- (5) Screen: Size 2, Length 10ft.
- (6) Were any formations sealed against pollution?

yes, X no.

If YES depth of formation

Why

Drillers Remarks:

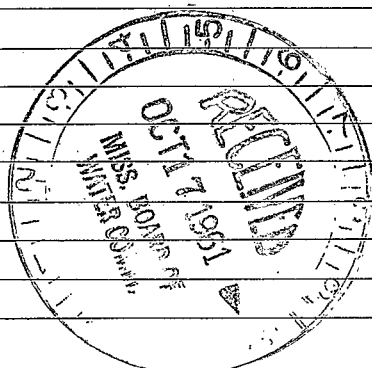

(Use Back Side)

Well No.

51