

G61

2-27-63

WATER WELL DRILLERS LOG

Date: 2/27, 1963, Driller: Barley Drilling Co. County: Washington
(Name)

(1) Owner of Land:	Description & Color of Materials	Thick- ness Feet	Depth Feet
<u>Greenville Spindle Co.</u> (Name) <u>Greenville, Miss.</u> (Address) <u>Swift water</u>	<u>Clay</u>		<u>30</u>
	<u>Sand</u>		<u>75</u>
(2) Location: <u>1/4</u> , <u>1/4</u> , Sec. <u>12</u> T <u>R</u>	<u>Mud</u>		<u>422</u>
<u>4</u> miles <u>South</u> of <u>Greenville</u> (distance) (direction) (Nearest Town)	<u>Sand</u>		<u>471</u>
(3) Topography: <u>Flat</u> (Hilly) (Flat) (Level)			
(4) Purpose of Well: <u>Industrial</u> (Domestic Irrigation Municipal, Industrial, Other)			


Information upon completion of well:

- (1) Diameter 4 X 2 inches.
- (2) Total Depth 471 feet.
- (3) Water Level 36 feet below top of ground.
- (4) Cased to all way, Size 4 X 2.
- (5) Screen: Size 2, Length 20 ft.
- (6) Were any formations sealed against pollution?
_____ yes, X no.

If YES depth of formation _____

Why _____

Drillers Remarks: _____

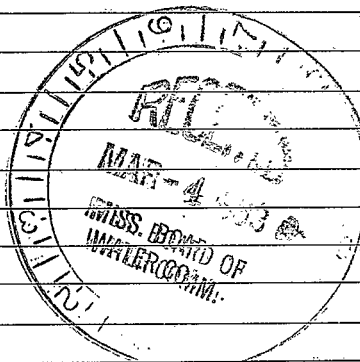

(Use Back Side)

Well No.

