

WASH.

662

4-16-64

WATER WELL DRILLERS LOG

Date: 4/16, 1964, Driller: Bailey Dalg. Co. County: Washington (Name)

(1) Owner of Land: Washington County (Name) (Bus Shop) Greenville, Miss. (Address)

(2) Location: 1/4, 1/4, Sec. 22 T R, miles (distance), of Swiftwater (Nearest Town)

(3) Topography: Flat (Hilly) (Flat) (Level)

(4) Purpose of Well: To wash trucks (Domestic Irrigation, Municipal, Industrial, Other)

Description & Color of Materials Sand, Clay, Red Clay, Shell, etc.	Thick- ness Feet	Depth Feet
Clay		30
Sand		50
mud		220
Sand		270
mud		370
Sand		470


Information upon completion of well:

- (1) Diameter 4 x 2 inches.
- (2) Total Depth 470 feet.
- (3) Water Level 30 feet below top of ground.
- (4) Cased to All way, Size 4 x 2.
- (5) Screen: Size 2" Length 20 ft.
- (6) Were any formations sealed against pollution?
yes, X no.

If YES depth of formation

Why

Drillers Remarks:

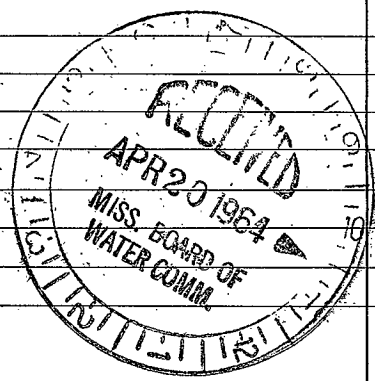

(Use Back Side)

Well No.

