

Washington
 963
 11-67

MISSISSIPPI
 BOARD OF WATER COMMISSIONERS
 416 North State Street
 Jackson, Mississippi 39201

WATER WELL DRILLERS LOG

11/21 1967 Bailey Drilling Co. Washington
 date well completed firm name county well located

LANDOWNER: Highland Plantations
 Greenville, Miss.
 (mailing address)


description of formations encountered	from	to
	Clay	0
Sand	40	90
Gravel	90	100
Mud	100	360
Fine Sand	360	395
Medium Sand	395	431

WELL LOCATION:
 sec. 14 T 17 N R 9 E
 4 miles SW of Greenville
 (distance) (direction) (nearest town)

WELL PURPOSE: Farm
 (home, irrigation, municipal, industrial)

- WELL COMPLETION DATA:
- (1) diameter (inches) 4 X 2 1/2
 - (2) total depth (feet) 431
 - (3) static water level (feet) 48 below above top of ground.
 - (4) casing steel (material) (depth) 4 X 2 1/2 (size) if telescope see back.
 - (5) screen 20' 4-1 (length) (depth to top) 2 1/2 (size) Stainless Steel (material)
 - (6) pump 3 40 (HP) (yield gpm) Elec (type power)
 - (7) electric log No (yes or no)
 - (organization running log)
 - (8) how well bottom plugged Back pressure valve

DRILLERS REMARKS:

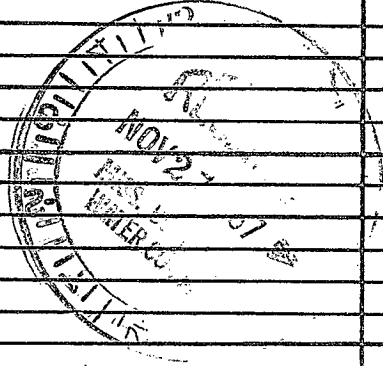

If well telescopes please sketch and show depths.

GROUND LEVEL

145' 4"

300' 2"

207' 3"
strainer

		X	

SECTION 14

Please indicate well location X.

ADDITIONAL INFORMATION

If more than one screen, show locations of each on sketch.