

G64

4-30-65

WATER WELL DRILLERS LOG

CODED

Date: 4/30, 1965, Driller: Bailey Drlg Co, County: Washington (Name)

| (1) Owner of Land: | Description & Color of Materials Sand, Clay, Red Clay, Shell, etc. | Thick- ness Feet | Depth Feet |
|---|---|------------------------|---------------|
| James Rowser (Name) Greenville, Miss. | Clay | | 30 |
| Swiftwater (Address) | Sand | | 60 |
| Location: SE 1/4, NE 1/4, Sec. 12 T12R8E | Gravel | | 70 |
| 4 miles S of Greenville | Mud | | 205 |
| (distance) (direction) (Nearest Town) | Sand & Mud | | 287 |
| (3) Topography: Flat | Mud | | 378 |
| (Hilly) (Flat) (Level) | Sand | | 369 |
| (4) Purpose of Well: Domestic | Mud & Sand | | 389 |
| (Domestic Irrigation Municipal, Industrial, Other) | Sand | | 475 |

Information upon completion of well:


- (1) Diameter 4x2 inches.
- (2) Total Depth 475 feet.
- (3) Water Level 27 feet below top of ground.
- (4) Cased to all way Size 4x2
- (5) Screen: Size 2", Length 10 ft
- (6) Were any formations sealed against pollution?
yes, no.

If YES depth of formation

Why

Drillers Remarks:

CODED

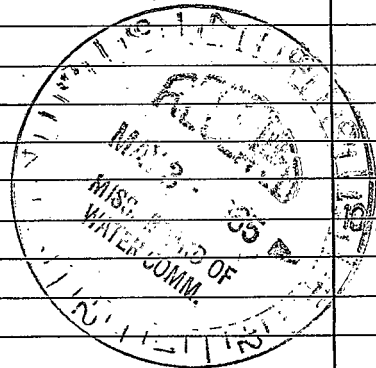

(Use Back Side)

Well No.

100

100