

Washington
G&G
9-20-68

MISSISSIPPI
BOARD OF WATER COMMISSIONERS
416 North State Street
Jackson, Mississippi 39201

CODED

WATER WELL DRILLERS LOG

9/20 1968 Bailey Drilg. Co. Washington
date well completed firm name county well located

LANDOWNER:
Swiftwater Community
Swiftwater, Miss.
(mailing address)

description of formations encountered	from	to
Clay	0	25
Sand	25	70
Gravel	70	80
Mud	80	210
Sand	210	285
Mud	285	360
Sand	360	370
Mud	370	372
Sand	372	460

WELL LOCATION:
sec. 12 T 17 N R 8 E W
at Swiftwater
(distance) (direction) (nearest town)

WELL PURPOSE: Community
(home, irrigation, municipal, industrial)

WELL COMPLETION DATA:

(1) diameter (inches) 8 x 4

(2) total depth (feet) 460

(3) static water level (feet) 41 below top of ground.

(4) casing Steel (material) (depth)

8 x 4 if telescope see back. (size)

(5) screen 30' 430' (length) (depth to top)


4" SS (size) (material)

(6) pump 10 (HP) 100 (yield gpm)

Elec (type power)

(7) electric log No (yes or no)

(organization running log)

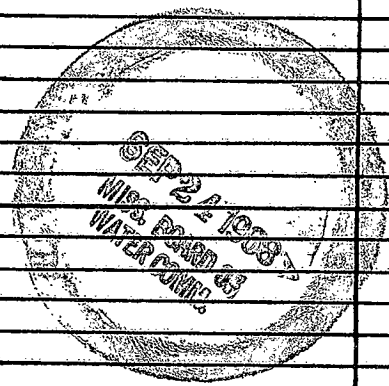

(8) how well bottom plugged Back pressure valve

DRILLERS REMARKS:

If well telescopes please sketch and show depths.

GROUND LEVEL

		X	

SECTION 12

Please indicate well location X.

ADDITIONAL INFORMATION

If more than one screen, show locations of each on sketch.