

Washington
 667
 3-67

MISSISSIPPI
 BOARD OF WATER COMMISSIONERS
 416 North State Street
 Jackson, Mississippi 39201

WATER WELL DRILLERS LOG

3/15 1967 Bailey Drlg. Co. Washington
 date well completed firm name county well located

LANDOWNER: Ernest Wells
 Greenville
 Miss.
 (mailing address)


description of formations encountered	from	to
Clay	0	20
Sand	20	82
mud	82	420
Sand	420	495

WELL LOCATION:
 sec. 19 T. 17 N. R. 9 E.
 S W
 2 miles W of Swiftwater
 (distance) (direction) (nearest town)

WELL PURPOSE:
 (home, irrigation, municipal, industrial)

WELL COMPLETION DATA:

- (1) diameter (inches) 2"
- (2) total depth (feet) 495
- (3) static water level (feet) 45 below top of ground.
- (4) casing Galv. 495 (material) (depth)
- (size) If telescope see back.
- (5) screen 10' 485 (length) (depth to top)
 2" Stainless Steel (size) (material)
- (6) pump 1 10 (HP) (yield gpm)
 Elee- (type power)
- (7) electric log no (yes or no)
- (organization running log)
- (8) how well bottom plugged Wash valve

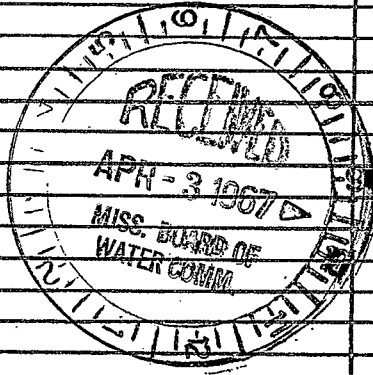

DRILLERS REMARKS:

If well telescopes please sketch and show depths.

GROUND LEVEL

	X		

SECTION 19

Please indicate well location X.

ADDITIONAL INFORMATION

If more than one screen, show locations of each on sketch.