

Washington
 G68
 6-67

MISSISSIPPI
 BOARD OF WATER COMMISSIONERS
 416 North State Street
 Jackson, Mississippi 39201

WATER WELL DRILLERS LOG

6/5-1967 date well completed
 Bailey Drlg Co firm name
 Washington county well located

LANDOWNER: Leroy Percy
 Greenville
 Miss.
 (mailing address)


description of formations encountered	from	to
	Clay	0
Sand	40	90
Mud	90	125
Sand	125	150.3

WELL LOCATION:
 sec. 17 T 17 N R 9 E W
 2 miles S of Greenville
 (distance) (direction) (nearest town)

WELL PURPOSE: Home
 (home, irrigation, municipal, industrial)

WELL COMPLETION DATA:

- (1) diameter (inches) 4 X 3 X 2 1/2
- (2) total depth (feet) 150.3
- (3) static water level (feet) 61 below top of ground.
- (4) casing galv. steel, 483 ft
 (material) (depth)
- (size) if telescope see back.
- (5) screen 20 ft, 483
 (length) (depth to top)
 2 1/2", stainless steel
 (size) (material)
- (6) pump 3, 40
 (HP) (yield gpm)
 electric
 (type power)
- (7) electric log No
 (yes or no)

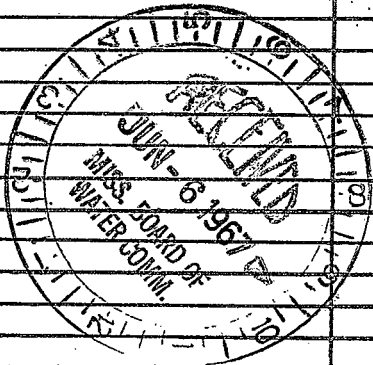

(organization running log)

(8) how well bottom plugged
 Back pressure valve

DRILLERS REMARKS:

