

Washington
G69
6-67

MISSISSIPPI
BOARD OF WATER COMMISSIONERS
416 North State Street
Jackson, Mississippi 39201
WATER WELL DRILLERS LOG

June 26 19 67 Dyer Well & Irr. Ser. Washington
date well completed firm name county well located

LANDOWNER: Dr. J. C. Willis

description of formations encountered from to

R. Rte, Glenn Allen

Clay 0 23
Fine sand & clay 23 33
Fine Sand 33 43
Coarse sand 43 63
Med. Sand 63 73
Med. Sand 73 93
Fine Sand 93 102

Miss.
(mailing address)

WELL LOCATION:


sec. 36 T. 17 N R. 8 E
6 miles So. of G-ville
(distance) (direction) (nearest town)

WELL PURPOSE: Irrigation
(home, irrigation, municipal, industrial)

WELL COMPLETION DATA:

- (1) diameter (inches) 16"
- (2) total depth (feet) 102'
- (3) static water level (feet) 20' below top of ground.
- (4) casing Blk. Ir. 82'
(material) (depth)
(size) if telescope see back.
- (5) screen 20' 82'
(length) (depth to top)
16" Blk. Ir.
(size) (material)
- (6) pump 25 1200
(HP) (yield gpm)
Diesel Power Unit
(type power)
- (7) electric log No
(yes or no)
(organization running log)
- (8) how well bottom plugged Steel plate wedged on bottom

DRILLERS REMARKS:

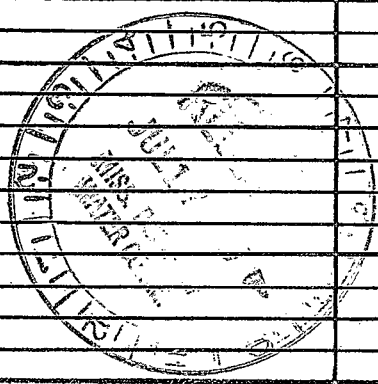

If well telescopes please sketch and show depths.

GROUND LEVEL

			X

SECTION 36

Please indicate well location X.

ADDITIONAL INFORMATION

If more than one screen, show locations of each on sketch.