


Washington
 G70
 6-67

MISSISSIPPI
 BOARD OF WATER COMMISSIONERS
 416 North State Street
 Jackson, Mississippi 39201

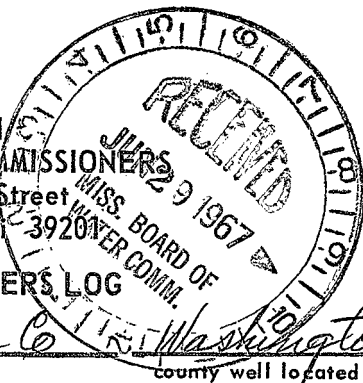

WATER WELL DRILLERS LOG

6/22 1967 Bailey Drilling Co. Washington
 date well/completed firm name county well located

LANDOWNER: W. Taylor
Greenville, Miss.
 (mailing address)

description of formations encountered	from	to
Clay	0	20
Sand	20	60
Gravel	60	65
Mud	65	420
Sand	420	446
Hard Mud	446	448
Sand	448	496

WELL LOCATION:
 sec. 12 T. 17 N. R. 8 W.
3 miles S of Greenville
 (distance) (direction) (nearest town)

WELL PURPOSE: Home
 (home, irrigation, municipal, industrial)

- WELL COMPLETION DATA:
- diameter (inches) 4 X 2
 - total depth (feet) 496
 - static water level (feet) 50 below above top of ground.
 - casing Steel (material) (depth)
4 X 2 if telescope see back. (size)
 - screen 15 (length) 481 (depth to top)
2" (size) Stainless steel (material)
 - pump 1 (HP) 20 (yield gpm)
Electric (type power)
 - electric log No (yes or no)
 (organization running log)
 - how well bottom plugged
Back pressure valve

DRILLERS REMARKS:


If well telescopes please sketch and show depths.

GROUND LEVEL

11" 107'

2" 334'

2' Strainer 15'

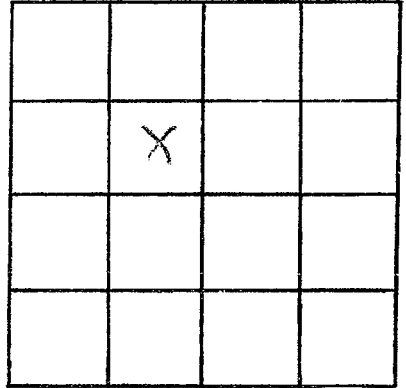

SECTION 12

Please indicate well location X.

ADDITIONAL INFORMATION

If more than one screen, show locations of each on sketch.