

Washington
G 710
7-67

MISSISSIPPI
BOARD OF WATER COMMISSIONERS
416 North State Street
Jackson, Mississippi 39201

WATER WELL DRILLERS LOG

July 21 1967 Schultz Drilling Washington
date well completed firm name county well located
0193

LANDOWNER: JULIAN HERREN
Rt. 2 Box 677
Greenville, Miss
(mailing address)

WELL LOCATION:
sec 32 T 17 N R 8 E
S
5 miles South of Greenville
(distance) (direction) (nearest town)

description of formations encountered	from	to
Clay	0	18
Sand	18	34
Clay	34	170
Fine Sand	170	185
Sandy Shale	185	240
Clay	240	360
Sand (Fine)	360	400
Clay & Shale to	400	460
Sand Good	460	480

WELL PURPOSE:
(home, irrigation, municipal, industrial)

WELL COMPLETION DATA:

(1) diameter (inches) 3 X 2

(2) total depth (feet) 477

(3) static water level (feet) 26 below top of ground.

(4) casing ~~467~~ 467
(material) (depth)
3 X 2 if telescope see back.
(size)


(5) screen 10
(length) (depth to top)
2" Stainless
(size) (material)

(6) pump 1 15
(HP) (yield gpm)
Elec
(type power)

(7) electric log NO
(yes or no)

(organization running log)

(8) how well bottom plugged P.V.

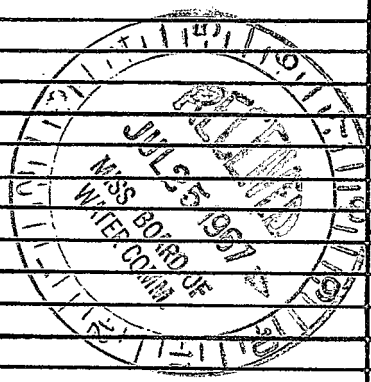

DRILLERS REMARKS:

If well telescopes please sketch and show depths.

GROUND LEVEL

3' 10" 1979

14' 10" 1979


5' 10" 1979

22' 10" 1979

10 ft. Stainless Steel

Screen

If more than one screen, show locations of each on sketch.

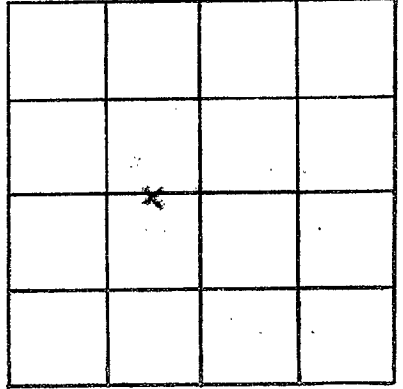

SECTION 32

Please indicate well location X.

ADDITIONAL INFORMATION

Lined area for additional information.