

Washington
 G72
 2-68

MISSISSIPPI
 BOARD OF WATER COMMISSIONERS
 416 North State Street
 Jackson, Mississippi 39201

WATER WELL DRILLERS LOG

Feb. 5 1968 date well completed
 Schultz Drilling Co. Washington firm name
 0198 county well located

LANDOWNER: Pent Johnson

description of formations encountered

Rt 2.
 Greenville Miss
 (mailing address)

description of formations encountered	from	to
Clay	0	22
Sand	22	83

WELL LOCATION:
 sec 23 T 17 N R 8 E
 2 miles South of Greenville
 (distance) (direction) (nearest town)

Clay	83	163
Rock 6"		
Clay	164	223


WELL PURPOSE: Home
 (home, irrigation, municipal, industrial)

Rock 4"	223	
---------	-----	--

WELL COMPLETION DATA:

- (1) diameter (inches) 2
- (2) total depth (feet) 477
- (3) static water level (feet) 26 below top of ground.
- (4) casing Pvc (material) 447 (depth)
- (size) if telescope see back.
- (5) screen 10 (length) 10 (depth to top)
- (size) 2 (material) Stainless
- (6) pump 1 (HP) 10 (yield gpm)
- (type power) Elec
- (7) electric log no (yes or no)
- (organization running log)
- (8) how well bottom plugged Per

Clay	323	320
Sand FINE	320	355
Clay	355	360
Sand	360	380
Stack of clay	380	382
Sand	382	480

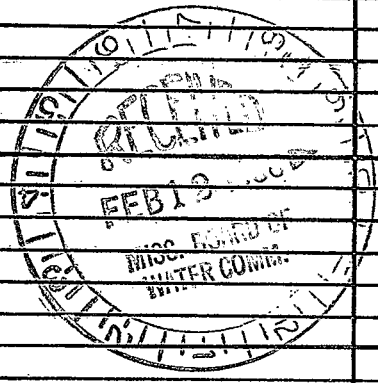

DRILLERS REMARKS:
 Sand fine to med

If well telescopes please sketch and show depths.

GROUND LEVEL

		6 feet	
	X		

SECTION 23

Please indicate well location X.

ADDITIONAL INFORMATION

If more than one screen, show locations of each on sketch.