

Washington  
 G ~~72~~ 73  
 7-67

MISSISSIPPI  
 BOARD OF WATER COMMISSIONERS  
 416 North State Street  
 Jackson, Mississippi 39201

WATER WELL DRILLERS LOG

July 16, 1967 date well completed  
 Shaly Drilling firm name  
 Washington county well located

LANDOWNER: Julian Herren

Rt 2 Box 697  
 Greenville Miss  
 (mailing address)

WELL LOCATION:  
 sec. 32 T. 17 N. R. 8 E  
 5 miles South of Greenville  
 (distance) (direction) (nearest town)


WELL PURPOSE: Home  
 (home, irrigation, municipal, industrial)

WELL COMPLETION DATA:

- (1) diameter (inches) 3x2
- (2) total depth (feet) 360
- (3) static water level (feet) 28 below top of ground.
- (4) casing Galv 350 (material) (depth)  
 3x2 (size) if telescope see back.
- (5) screen 10 (length) (depth to top)  
 2' (size) (material)
- (6) pump 1 (HP) 12 (yield gpm)  
 Ele (type power)
- (7) electric log No (yes or no)  
 (organization running log)
- (8) how well bottom plugged Plug

description of formations encountered	from	to
	clay	0
Sand	18	85
Fine Sand	170	185
Sand Shale	185	240
Clay	240	360
Sand	360	400

This is to replace the Log Made July 21, 1967  
 The 477 ft well was SALT WATER

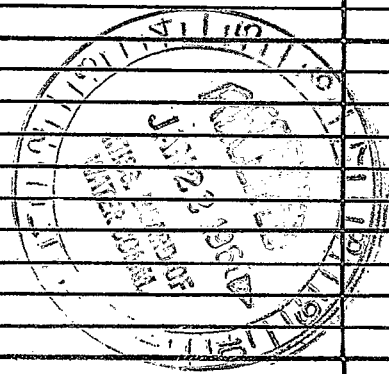

DRILLERS REMARKS:

