

Washington  
G 79  
8-68

MISSISSIPPI  
BOARD OF WATER COMMISSIONERS  
416 North State Street  
Jackson, Mississippi 39201

CODED

WATER WELL DRILLERS LOG

Aug 30 1968 Schultz Drilling Washington  
date well completed firm name county well located

LANDOWNER: Carroll Evans  
Rt. 1  
Greenville Miss  
(mailing address)

description of formations encountered	from	to
Clay	0	16
Sand	16	96

WELL LOCATION:  
sec. 26 T. 17 N. R. 8 E  
2 1/2 miles South of Shannon  
(distance) (direction) (nearest town)

Clay	96	163
<del>Clay</del> Sand	103	163

WELL PURPOSE: Dom  
(home, irrigation, municipal, industrial)

Clay	163	169
------	-----	-----

WELL COMPLETION DATA:  
(1) diameter (inches) 2"  
(2) total depth (feet) 388  
(3) static water level (feet) 27 below top of ground.  
(4) casing Galv, 308,  
(material) (depth)

Sand	169	243
Clay	243	280
Sand, Clay Struck	280	340
Sand	340	400


         if telescope see back.  
(size)  
(5) screen 10,           
(length) (depth to top)  
2", Stainless  
(size) (material)

(6) pump 1, 10  
(HP) (yield gpm)  
Ele  
(type power)

(7) electric log No  
(yes or no)  
          
(organization running log)


(8) how well bottom plugged Spaced

DRILLERS REMARKS:

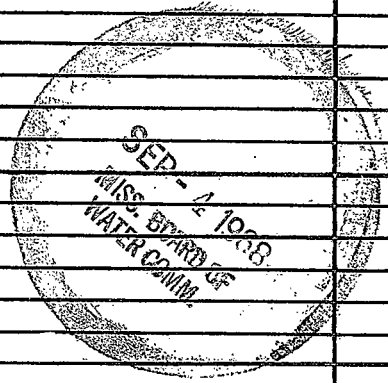

If well telescopes please sketch and show depths.

GROUND LEVEL

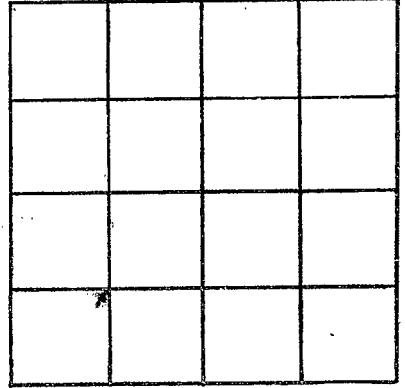

SECTION 216

Please indicate well location X.

ADDITIONAL INFORMATION

If more than one screen, show locations of each on sketch.