

Washington
 G 80
 8-68

MISSISSIPPI
 BOARD OF WATER COMMISSIONERS
 416 North State Street
 Jackson, Mississippi 39201

CODED

WATER WELL DRILLERS LOG

Aug 30 19 Schulte Drilling Washington
 date well completed firm name county well located


LANDOWNER: Malcolm Welton
 Rt. 2
 Greenville Miss
 (mailing address)

WELL LOCATION:
 sec. 22 T. 12 N R. 8 E S. 3
 2 miles South of Lvl
 (distance) (direction) (nearest town)

WELL PURPOSE: Home
 (home, irrigation, municipal, industrial)

- WELL COMPLETION DATA:
- (1) diameter (inches) 2"
 - (2) total depth (feet) 472'
 - (3) static water level (feet) 380 below top of ground.
 - (4) casing Galv. 472' (material) (depth)
 no (size) if telescope see back.
 - (5) screen 10' (length) (depth to top)
 2' (size) Stainless (material)
 - (6) pump 10 (HP) 10 gpm (yield gpm)
 Elec (type power)
 - (7) electric log No (yes or no)
 (organization running log)
 - (8) how well bottom plugged S/w


description of formations encountered	from	to
Clay	0	21
Sand	21	86
Clay	86	175
Rock + Sand (Rock 2")	175	180
Clay	180	320
Sand	320	360
Shale, Clay	360	390
Sand	390	480

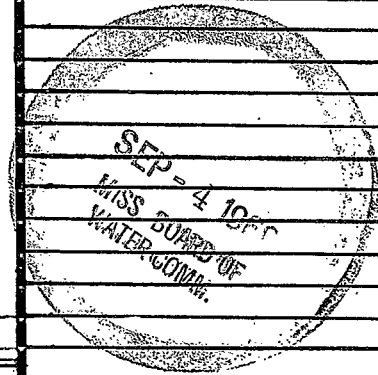

DRILLERS REMARKS:

If well telescopes please sketch and show depths.

GROUND LEVEL

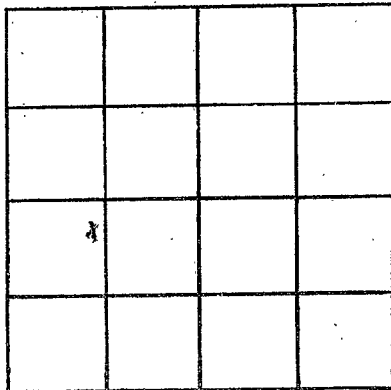

SECTION 22

Please indicate well location X.

ADDITIONAL INFORMATION

If more than one screen, show locations of each on sketch.