

WASHINGTON  
 C 82  
 3-68

MISSISSIPPI  
 BOARD OF WATER COMMISSIONERS  
 416 North State Street  
 Jackson, Mississippi 39201

CODED

WATER WELL DRILLERS LOG

3-5 1968 Dyer Well + Irr. WASHINGTON  
 date well completed firm name county well located

LANDOWNER: Dr. J.C. Willis  
 R.R.

HOLLANDALE, Miss.  
 (mailing address)


WELL LOCATION:  
 sec 37 T. 17 N R 8 W  
 2 1/2 miles EAST of WAYSIDE  
 (distance) (direction) (nearest town)

WELL PURPOSE: None  
 (home, irrigation, municipal, industrial)

WELL COMPLETION DATA:

- (1) diameter (inches) 4" x 2"
- (2) total depth (feet) 482 FT
- (3) static water level (feet) 22 below top of ground.
- (4) casing 4" BLK 126' BAL 2" GALV. 462 FT.  
 (material) (depth)
- (size) if telescope see back.
- (5) screen 20' , 462 FT  
 (length) (depth to top)  
 2" STAINLESS STEEL  
 (size) (material)
- (6) pump 1 18  
 (HP) (yield gpm)  
 ELEC.  
 (type power)
- (7) electric log No  
 (yes or no)  
 (organization running log)  
 BACK WASH
- (8) how well bottom plugged UALDE

description of formations encountered	from	to
CLAY	0	25
SAND	25	68
GRAVEL	68	128
CLAY + SHALE ST	128	182
ROCK	182	183
CLAY SHALE	183	240
SANDY SHALE	240	308
ROCK	308	310
Gummy SHALE	310	365
STREAKED SAND	365	418
SAND	418	485
CLAY + SHALE	485	500

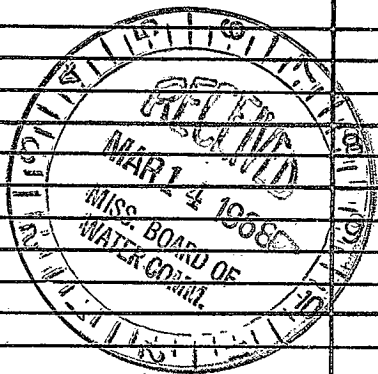

DRILLERS REMARKS:

