

G 87
7-15-64

CODED

WATER WELL DRILLERS LOG

Date: 7/14, 1964, Driller: Bailey Drilling Co. County: Washington
(Name)

(1) Owner of Land	Description & Color of Materials Sand, Clay, Red Clay, Shell, etc.	Thick- ness Feet	Depth Feet
Percy Alexander (Name) Mayside, Miss. (Address)	Clay		30
	Sand		70
38 17N 8W	Gravel		75
3 miles E of Mayside (distance) (direction) (Nearest Town)	Mud		440
(3) Topography: Flat (Hilly) (Flat) (Level)	Sand		450
(4) Purpose of Well: Domestic (Domestic Irrigation Municipal, Industrial, Other)			


CODED

Information upon completion of well:

- (1) Diameter 2 inches.
- (2) Total Depth 450 feet.
- (3) Water Level 19 feet below top of ground.
- (4) Cased to all way size 2
- (5) Screen: Size 2, Length 5 ft.
- (6) Were any formations sealed against pollution?
yes, X no.

Inset info
to locate

If YES depth of formation
Why
Drillers Remarks:

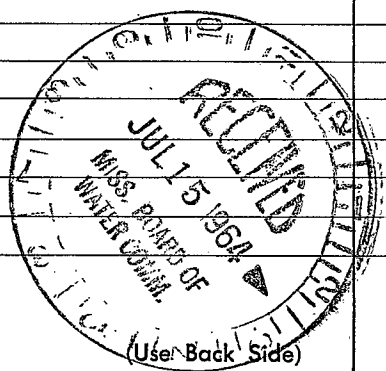

El 2
112

Well No.

