

WASH.

G91
6-4-64

WATER WELL DRILLERS LOG

CODED

Date: 6/4, 1964, Driller: Pailey Drlg Co. County: Washington
(Name)

	Description & Color of Materials Sand, Clay, Red Clay, Shell, etc.	Thick- ness Feet	Depth Feet
(1) Owner of Land: <u>Harden King</u> (Name) <u>Greenville, Miss.</u> NW 1/4 82 W (Address)	<u>Clay</u>		<u>30</u>
	<u>Sand</u>		<u>60</u>
(2) Location: <u>1/4</u> , <u>1/4</u> , Sec. <u>3</u> T <u>R</u> <u>17 N 9 W</u>	<u>Gravel</u>		<u>65</u>
<u>5</u> miles <u>SW</u> , of <u>Greenville</u>	<u>Mud</u>		<u>400</u>
(distance) (direction) (Nearest Town)	<u>Sand</u>		<u>425</u>
(3) Topography: <u>Flat</u> (Hilly) (Flat) (Level)			
(4) Purpose of Well: <u>domestic</u> (Domestic Irrigation Municipal, Industrial, Other)			

CODED

Information upon completion of well:


- (1) Diameter 2 inches.
- (2) Total Depth 425 feet.
- (3) Water Level 37 feet below top of ground.
- (4) Cased to all way, Size 2
- (5) Screen: Size 2, Length 10ft
- (6) Were any formations sealed against pollution?
_____ yes, X no.

Insert info to locate

If YES depth of formation _____

Why _____

Drillers Remarks: _____

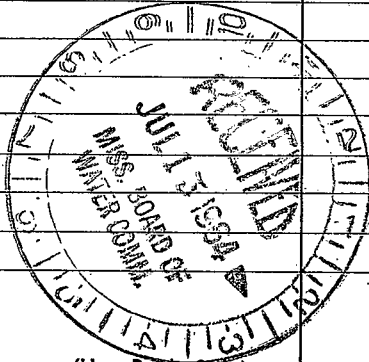

(Use Back Side)

Well No.

