

G 92

CODED

CODED

2-23-63

WATER WELL DRILLERS LOG

Date: 2/23, 1963, Driller: Bailey Drlg Co County: Washington
(Name)

(1) Owner of Land: J J Smith
(Name)
Greenville, Miss.
(Address)

(2) Location: 1/4, 1/4, Sec. 13 NW 80
T R
4 miles SE of Greenville
(distance) (direction) (Nearest Town)

(3) Topography: Flat
(Hilly) (Flat) (Level)

(4) Purpose of Well: domestic
(Domestic Irrigation
 Municipal, Industrial, Other)

Description & Color of Materials Sand, Clay, Red Clay, Shell, etc.	Thick- ness Feet	Depth Feet
<u>Clay</u>		<u>10</u>
<u>Sand</u>		<u>87</u>
<u>Gravel</u>		<u>102</u>
<u>Mud</u>		<u>440</u>
<u>Sand</u>		<u>471</u>

CODED

Information upon completion of well:

(1) Diameter 4X2 inches.

(2) Total Depth 471 feet.

(3) Water Level 35 feet below top of ground.

(4) Cased to all way Size 4X2

(5) Screen: Size 2, Length 20ft


(6) Were any formations sealed against pollution?
 _____ yes, X no.

Insuff. info
to locate

If YES depth of formation _____

Why _____

Drillers Remarks: _____

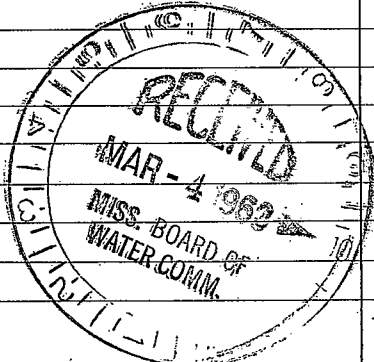

(Use Back Side)

Well No.

