

Washington  
 G 95  
 2-18-69

MISSISSIPPI  
 BOARD OF WATER COMMISSIONERS  
 416 North State Street  
 Jackson, Mississippi 39201

CODED 2/18/69  
 C2802  
 Irrigation Well

WATER WELL DRILLERS LOG

February 18, 1969 Layne-Central Company Washington  
 date well completed firm name county well located

LANDOWNER: Greenville Country Club	description of formations encountered	from	to
	Clay	0	22
Greenville, Mississippi	Fine sand	22	40
(mailing address)	Coarse sand	40	94
<b>WELL LOCATION:</b>			
sec. 9 T. 17 N R. 8 Ex			
Highway #1 South of Scott			
(distance) (direction) (nearest town)			
<b>WELL PURPOSE:</b> (home, irrigation, municipal, industrial)			
<b>WELL COMPLETION DATA:</b>			
(1) diameter (inches) 16			
(2) total depth (feet) 94			
(3) static water level (feet) 7 <del>xx</del> above top of ground.			
(4) casing steel 74' (material) (depth)			
16" (size) if telescope see back.			
(5) screen 20' 94' (length) (depth to top)			
16" Armco (size) (material)			
(6) pump 100 2500 (HP) (yield gpm)			
electric (type power)			
(7) electric log no (yes or no)			
(organization running log)			
(8) how well bottom plugged plate			
<b>DRILLERS REMARKS:</b>			


CODED

MAR 21 1969

MISS. DD. 68  
 WATER COMMISSION

If well telescopes please  
sketch, and show depths.

GROUND LEVEL

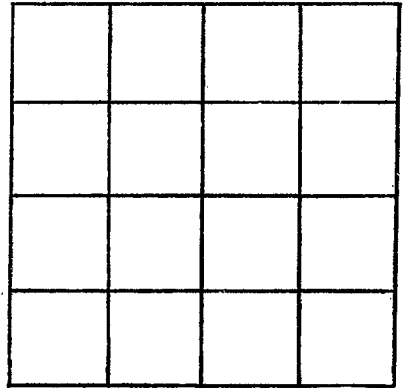

SECTION 9

Please indicate well location X.

ADDITIONAL INFORMATION

A series of horizontal lines for providing additional information, located below the 'ADDITIONAL INFORMATION' header.

If more than one screen,  
show locations of each on sketch.