

CODED

Washington
G 102
6-69

MISSISSIPPI
BOARD OF WATER COMMISSIONERS
416 North State Street
Jackson, Mississippi 39201

WATER WELL DRILLERS LOG

June 1969 date well completed
Schubert Drilling firm name
Washington county well located

LANDOWNER: Leon Sumby
RT 2
Ansonville Mo
(mailing address)

description of formations encountered	from	to
Clay	0	16
Sand	16	88

WELL LOCATION:
sec 27 T 17 N R 8 E
2 1/2 miles South of Ansonville Mo
(distance) (direction) (nearest town)

Clay	88	103
Sandy Shale	103	160

WELL PURPOSE: Home
(home; irrigation, municipal, industrial)

Clay	160	169
------	-----	-----

WELL COMPLETION DATA:

Sand	169	243
------	-----	-----

- (1) diameter (inches) 4" x 2"
- (2) total depth (feet) 365
- (3) static water level (feet) 27 below top of ground
- (4) casing Gal (material), (depth)

Clay	243	280
Sandy Shale	280	340
Sand	340	365

1 1/2" (size) if telescope see back.

- (5) screen 20 (length), (depth to top)
2" (size), Stainless (material)

- (6) pump 1 (HP), 30 (yield gpm)
Etc (type power)

- (7) electric log No (yes or no)

(organization running log)



- (8) how well bottom plugged

DRILLERS REMARKS:

JUN 11 1969
MISS. Bd. of
WATER COMMISSIONERS

If well telescopes please sketch and show depths.

GROUND LEVEL

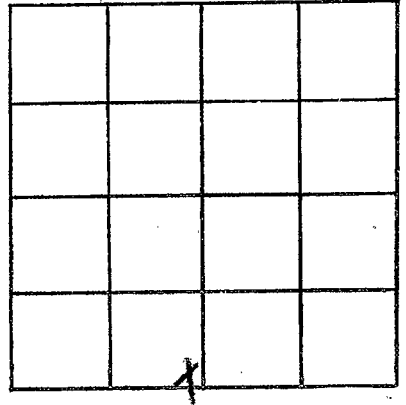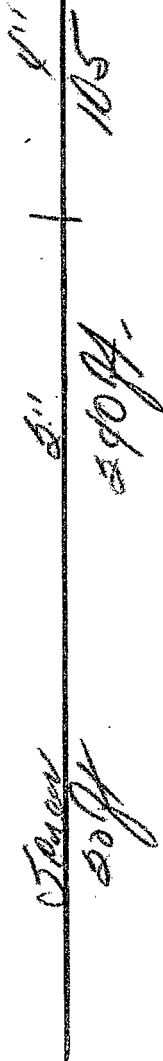

SECTION 27

Please indicate well location X.

ADDITIONAL INFORMATION

If more than one screen, show locations of each on sketch.